


WELL PLUGGING RECORD

Give All Information Completely
Make Required Affidavit
Mail or Deliver Report to:
Conservation Division
State Corporation Commission
211 No. Broadway
Wichita, Kansas

STAFFORD County, Sec. 15 Twp. 22 Rge. 14W (E) (W)

Location as "NE/CNW%SW%" or footage from lines. NE SE NW
Lease Owner PETROLEUM, INC.
Lease Name SMITH "A-H" Well No. 1
Office Address ROUTE 2, GREAT BEND, KANSAS
Character of Well (completed as Oil, Gas or Dry Hole) DRY HOLE
Date well completed MAY 8, 1963
Application for plugging filed MAY 8, 1963
Application for plugging approved MAY 8, 1963
Plugging commenced MAY 8, 1963
Plugging completed MAY 8, 1963
Reason for abandonment of well or producing formation NO PRODUCIBLE FORMATIONS
If a producing well is abandoned, date of last production NONE 19
Was permission obtained from the Conservation Division or its agents before plugging was commenced? YES

NORTH

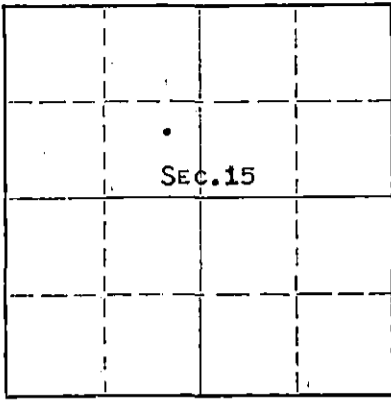

Locate well correctly on above Section Plat

Name of Conservation Agent who supervised plugging of this well ARCHIE ELVING
Producing formation Depth to top Bottom Total Depth of Well 3626 Feet
Show depth and thickness of all water, oil and gas formations.

OIL, GAS OR WATER RECORDS

CASING RECORD

FORMATION	CONTENT	FROM	TO	SIZE	PUT IN	PULLED OUT
				8-5/8"	257'	NONE

Describe in detail the manner in which the well was plugged, indicating where the mud fluid was placed and the method or methods used in introducing it into the hole. If cement or other plugs were used, state the character of same and depth placed, from feet to feet for each plug set.

MUDDED UP WITH HEAVY MUD TO 250' FOLLOWED BY WOODEN PLUG AND 1/4 SACK HULLS. PLACED 25 SACKS CEMENT THROUGH DRILL ONTO HULLS. MUDDED UP WITH HEAVY MUD TO 40', FOLLOWED BY WOODEN PLUG, 1/4 SACK HULLS, AND 15 SACKS CEMENT TO BASE OF WELL CELLAR. PLACED 2 SACKS CEMENT IN RAT HOLE.

RECEIVED
STATE CORPORATION COMMISSION

MAY 15 1963

CONSERVATION DIVISION
Wichita, Kansas

5-15-63

(If additional description is necessary, use BACK of this sheet)
Name of Plugging Contractor GARVEY DRILLING COMPANY
Address ROUTE 2, GREAT BEND, KANSAS

STATE OF KANSAS, COUNTY OF BARTON, ss.
DON SEARLE (employee of owner) or (~~owner~~) of the above-described well, being first duly sworn on oath, says: That I have knowledge of the facts, statements, and matters herein contained and the log of the above-described well as filed and that the same are true and correct. So help me God. DON SEARLE, DIST. PROD. SUPT.
(Signature) Don Searle
ROUTE 2, GREAT BEND, KANSAS
(Address)

SUBSCRIBED AND SWORN to before me this 13TH day of MAY, 19 63

My commission expires APRIL 14, 1967
Arthur J. Miles Notary Public.



WELL LOG

15-185-01417-0000

COMPANY Petroleum Inc.

SEC. 15 T. 22S R. 14W

FARM Smith AH

NO. 1

LOC. NE SE NW


TOTAL DEPTH 3626'

COUNTY Stafford

COMM. 5-2-63

COMP. 5-8-63

CONTRACTOR Garvey Drilling Company

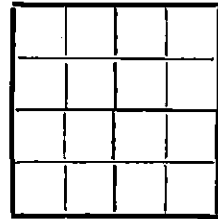

CASING 8 5/8" @ 257.37' w/250 sx

ELEVATION 1942' D.F.

PRODUCTION D & A

FIGURES INDICATE BOTTOM OF FORMATIONS

- 140' Sand and Gravel
- 258' Blue Shale and Shells
- 660' Red Bed
- 835' Red Bed and Shale
- 855' Anhydrite
- 1520' Shale and Shells
- 1835' Shale and Lime
- 2170' Lime
- 2280' Lime and Shale
- 2355' Shale w/Lime Streaks
- 2835' Shale
- 3119' Shale and Lime
- 3228' Lime
- 3440' Lime and Shale
- 3626' Lime
- 3626' RTD

RECEIVED
STATE CORPORATION COMMISSION

MAY 15 1963

CONSERVATION
DIVISION
Topeka, Kansas

State of Kansas }
County of Barton } ss

I, Sam N. Stephens of Garvey Drilling Company

upon oath state the above and foregoing is a true and correct copy of the log of the Smith AH #1 well.

Subscribed and sworn to before me this 10th day of May 19 63

My Commission Expires: April 14th, 1967

Sam N. Stephens
Arthur J. Wiles
 NOTARY PUBLIC