


Give All Information Completely
Make Required Affidavit
Mail or Deliver Report to:
Conservation Division
State Corporation Commission
211 No. Broadway
Wichita, Kansas

WELL PLUGGING RECORD

Pawnee County, Sec. 32 Twp. 22S Rge. 15W (XXXXXX) NW SE SE

NORTH

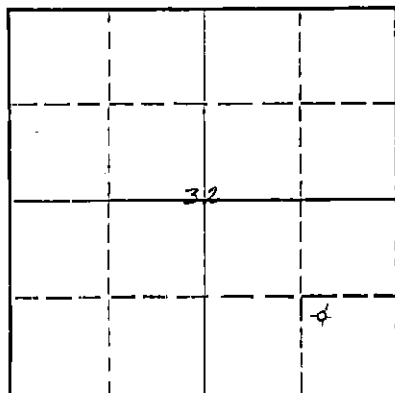

Locate well correctly on above Section Plat

Location as "NE/CNW/SW" or footage from lines
Lease Owner Mayfield-Smith Drig., Inc., W. R. Gross, et al
Lease Name Rice Well No. 1
Office Address 928 Union Center, Wichita, Kansas
Character of Well (completed as Oil, Gas or Dry Hole) Dry Hole
Date well completed August 22 19 63
Application for plugging filed August 22 19 63
Application for plugging approved August 22 19 63
Plugging commenced August 22 19 63
Plugging completed August 22 19 63

Reason for abandonment of well or producing formation
Oil in commercial quantities not found.

If a producing well is abandoned, date of last production - - - 19 - - -

Was permission obtained from the Conservation Division or its agents before plugging was commenced? Yes

Name of Conservation Agent who supervised plugging of this well Eldon Petty, Hays, Kansas

Producing formation - - - Depth to top - - - Bottom - - - Total Depth of Well 3650 Feet

Show depth and thickness of all water, oil and gas formations.

OIL, GAS OR WATER RECORDS

CASING RECORD

FORMATION	CONTENT	FROM	TO	SIZE	PUT IN	PULLED OUT
				8 5/8"	291.97'	None

Describe in detail the manner in which the well was plugged, indicating where the mud fluid was placed and the method or methods used in introducing it into the hole. If cement or other plugs were used, state the character of same and depth placed, from - - - feet to - - - feet for each plug set.

Filled hole with heavy Rotary Mud to 280'.
Set #1 Plug at 280' with 25 Sacks Cement, 1 Sack Hulls.
Set #2 Plug at 40' with 10 Sacks Cement, 2 sacks Cement in Rat Hole.

RECEIVED
STATE CORPORATION COMMISSION

SEP 30 1963

9-30-63

CONSERVATION DIVISION
Wichita, Kansas

(If additional description is necessary, use BACK of this sheet)
Name of Plugging Contractor Mayfield-Smith Drilling, Inc.
Address 928 Union Center Bldg., Wichita 2, Kansas

STATE OF Kansas, COUNTY OF Sedgwick, ss.
Edgar E. Smith (employee of owner) or (owner or operator) of the above-described well, being first duly sworn on oath, says: That I have knowledge of the facts, statements, and matters herein contained and the log of the above-described well as filed and that the same are true and correct. So help me God.

(Signature) Edgar E. Smith
928 Union Center, Wichita 2, Kansas
(Address)

SUBSCRIBED AND SWORN TO before me this 23rd day of September, 19 63

Commission expires 10-26-65

Marguerite Mayfield
Marguerite Mayfield Notary Public.

MAYFIELD-SMITH DRILLING, INC.
 928 Union Center Bldg.
 Wichita, Kansas

Re: #1 Rice NW SE SE
 Sec. 32-22S-15W
 Pawnee County, Kansas

DRILLERS LOG

Date Started: August 15, 1963
 Date Completed: August 22, 1963
 Casing: Set 291.97' of 8 5/8" With 300 Sacks Cement.

TOPS

Elevation: 2012 Kelly Bushing

0 - 255	Sandy, Yellow Clay	Heebner	3467 - 1455
255 - 289	Blue Shale	Toronto	3500 - 1488
289 - 450	Blue Shale & Red Bed	Brown Lime	3591 - 1579
450 - 525	Sand	Lansing	3600 - 1588
525 - 650	Shale	Total Depth	3650 - 1638
650 - 968	Red Bed & Sand		
968 - 990	Anhydrite		
990 - 1710	Shale		
1710 - 3320	Lime & Shale		
3320 - 3431	Lime		
3431 - 3485	Lime & Shale		
3485 - 3650	Lime		

RECEIVED
 STATE CORPORATION COMMISSION

SEP 30 1963

CONSERVATION DIVISION
 Wichita, Kansas

AFFIDAVIT

State of Kansas)
) SS
 County of Sedgwick)


I, Edgar E. Smith, do hereby certify that the above and foregoing is a true and correct Log of the #1 Rice, located in the NW SE SE of Section 32, Township 22 South, Range 15 West, Pawnee County, Kansas, as reflected by the Daily Drilling Reports of Mayfield-Smith Drilling, Inc.


 Edgar E. Smith

State of Kansas)
) SS
 County of Sedgwick)

Subscribed and sworn to before me this 23rd day of September, 1963, a Notary Public in and for Sedgwick County, Kansas.

My Comm. Expires: 10-26-65

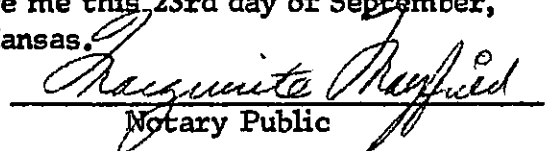
 Notary Public