

STATE OF KANSAS  
STATE CORPORATION COMMISSION

WELL PLUGGING RECORD

Give All Information Completely  
Make Required Affidavit  
Mail & Deliver Report to:  
Conservation Division  
State Corporation Commission  
800 Bittling Building  
Wichita, Kansas

Pawnee County.

Sec. 35 Twp. 22 Rge. 15 (E) W. (W)

Location as "NE/CNW/SW" or footage from lines 990' S. & 330' W. of Gen.

Lease Owner Cities Service Oil Company et al.

Lease Name Guffey Well No. 1

Office Address Bartlesville, Oklahoma

Character of Well (completed as Oil, Gas or Dry Hole) Dry Hole

Date well completed August 13, 19 54

Application for plugging filed August 13, 19 54

Application for plugging approved August 13, 19 54


Plugging commenced August 13, 19 54

Plugging completed August 13, 19 54

Reason for abandonment of well or producing formation Dry Hole

If a producing well is abandoned, date of last production --- 19 ---

Was permission obtained from the Conservation Division or its agents before plugging was commenced? Yes

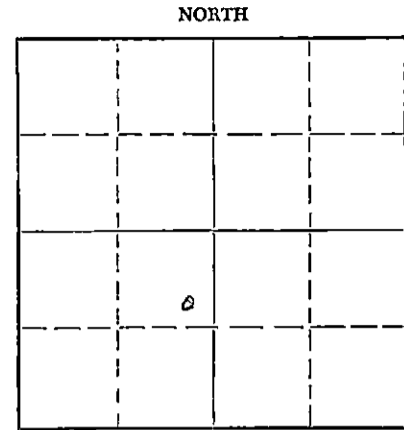

Locate well correctly on above Section Plat

Name of Conservation Agent who supervised plugging of this well M. A. Rives

Producing formation Arbuckle Depth to top 4010 Bottom 4020 Total Depth of Well 4020 Feet

Show depth and thickness of all water, oil and gas formations.

OIL, GAS OR WATER RECORDS

CASING RECORD

FORMATION	CONTENT	FROM	TO	SIZE	PUT IN	PULLED OUT
				8-5/8"	207'	None

Describe in detail the manner in which the well was plugged, indicating where the mud fluid was placed and the method or methods used in introducing it into the hole. If cement or other plugs were used, state the character of same and depth placed, from \_\_\_\_\_ feet to \_\_\_\_\_ feet for each plug set.

4020-205', heavy mud.  
205-140', 1/3 sack hulls, wood plug and 20 sacks cement.  
140-40', mud.  
40' to base of cellar, 1/3 sack hulls, wood plug and 15 sacks cement.

8-19-54

(If additional description is necessary, use BACK of this sheet)

Name of Plugging Contractor Natural Oil & Gas Company  
Address 1009 Central Building, Wichita, Kansas

STATE OF Kansas, COUNTY OF Barton, ss.  
V. M. Conover (employee of owner) or Cities Service Oil Company of the above-described well, being first duly sworn on oath, says: That I have knowledge of the facts, statements, and matters herein contained and the log of the above-described well as filed and that the same are true and correct. So help me God.

(Signature) V. M. Conover  
Box 751, Great Bend, Kansas  
(Address)

SUBSCRIBED AND SWORN TO before me this 17th day of August, 19 54

N. E. Smith  
Notary Public.

My commission expires March 12, 1955.

PLUGGING  
FILE SEC 35 T 22 R 15W  
BOOK PAGE 56 LINES 21

# WELL RECORD

Company Cities Service Oil Co. and Natural Gas & Oil Co. Well No. 1 Farm Guffey  
 Location 990' South and 330' West of Center Sec. 35 T. 22 R. 15W  
 Elevation 1999 (1995 Gr.) County Pawnee State Kansas  
 Drlg. Comm. July 31, 1954 Contractor Natural Gas & Oil Co.  
 Drlg. Comp. August 12, 1954 Acid None  
 T. D. 4020' Initial Prod. Dry Hole - P. & A. August 13, 1954

CASING RECORD:

8-5/8" @ 207' con. 225 sac cement

FORMATION RECORD:

cellar	0-9
clay	15
sand	115
shale & shells	208
shale, sand & red bed	395
sand	550
red bed & shale	925
anhydrite	950
shale & shells	1430
salt, shale & shells	1700
shale & lime streaks	1845
lime & shale	2495
shale & lime streaks	2610
lime & shale	2740
shale & lime	3000
lime & shale	3205
lime	3285
lime & shale	3546
lime	3790
lime & shale	3882
conglomerate	3902
lime & chert	3959
lime & shale	3995
shale & lime	4012
lime	4020 T. D.

Topoka	3040'
Heobner	3418'
Brown Limestone	3546'
Lansing	3557'
Cherty Conglomerate	3878'
Viola	3901'
Simpson Shale	3972'
Arbuckle	4010'
Penetration	10'
Total Depth	4020'

D. S. T. 3678-90, open 1 hr.,  
recovered 95' watery oil-cut  
mud; B. H. P. 1210#/30 mins.

D. S. T. 3728-35, open 1 hr.,  
recovered 35' slightly oil-cut  
mud; B. H. P. 1130#/30 mins.

D. S. T. 3751-65, open 1 hr.,  
recovered 12' mud; B. H. P.  
470#/30 mins.

D. S. T. 4011-20, open 1 hr.,  
recovered 2440' salt water;  
B. H. P. 1295#/30 mins.

SLOPE TESTS (SURE SHOT): 500' 3/4°  
1000' 1/4°  
1500' 1/2°  
2000' 1/2°  
2500' 1/2°  
3000' 1/2°  
3500' 1/2°

RECEIVED  
STATE CORPORATIONS COMMISSION

AUG 17 1954  
CONSERVATION DIVISION  
Wichita, Kansas

PLUGGING

FILE SEC 35 T 22 R 15W

BOOK PAGE 36 LINE 21