


STATE OF KANSAS
STATE CORPORATION COMMISSION

WELL PLUGGING RECORD

Give All Information Completely
Make Required Affidavit
Mail or Deliver Report to:
Conservation Division
State Corporation Commission
800 Etting Building
Wichita, Kansas

Stafford County. Sec. 16 Twp. 22S Rge. 11W (E) (W)
Location as "NE/CNW $\frac{1}{4}$ SW $\frac{1}{4}$ " or footage from lines NE NE NE
Lease Owner Imperial Petroleum Company, Inc.
Lease Name Dralle Well No. 1
Office Address Union National Bank Bldg., Wichita, Kansas
Character of Well (completed as Oil, Gas or Dry Hole) Dry Hole
Date well completed April 9 1951
Application for plugging filed April 9 1951
Application for plugging approved April 9 1951
Plugging commenced 1:00 P.M., April 9 1951
Plugging completed 3:00 P.M., April 9 1951
Reason for abandonment of well or producing formation Commercial quantity of oil not found.
If a producing well is abandoned, date of last production 19
Was permission obtained from the Conservation Division or its agents before plugging was commenced? Yes

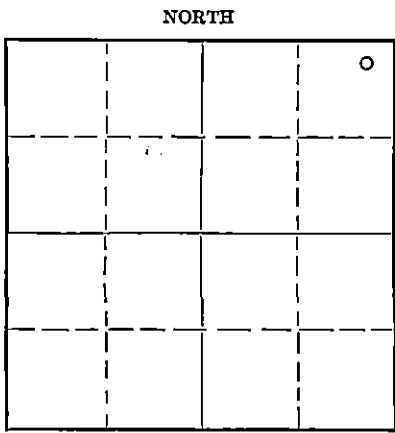

Locate well correctly on above Section Flat

Name of Conservation Agent who supervised plugging of this well Mr. Durkee
Producing formation Depth to top Bottom Total Depth of Well Feet
Show depth and thickness of all water, oil and gas formations.

OIL, GAS OR WATER RECORDS

CASING RECORD

Formation	Content	From	To	Size	Put In	Pulled Out
				8 5/8"	306	None

Describe in detail the manner in which the well was plugged, indicating where the mud fluid was placed and the method or methods used in introducing it into the hole. If cement or other plugs were used, state the character of same and depth placed, from feet to feet for each plug set.

Filled hole with heavy mud. Set wooden plug at 300' with 15 Sx. of cement; set another wooden plug at 30' with 10 Sx. cement.

4-13-51

(If additional description is necessary, use BACK of this sheet)

Correspondence regarding this well should be addressed to Imperial Petroleum Company, Inc.
Address Union National Bank Bldg., Wichita, Kansas

STATE OF KANSAS, COUNTY OF SEDGWICK, ss.
Clinton Engstrand, agent for (employee of owner) or (owner or operator) of the above-described well, being first duly sworn on oath, says: That I have knowledge of the facts, statements, and matters herein contained and the log of the above-described well as filed and that the same are true and correct. So help me God.

(Signature) *Clinton Engstrand*
1006 Central Building, Wichita, Kansas
(Address)

SUBSCRIBED AND SWORN TO before me this 12th day of April, 1951
[Signature]
Notary Public.

My commission expires 6-5-51

PLUGGING
FILE SEC. 16 T. 22 S. R. 11 W.
BOOK PAGE 73 LINE 18

