


STATE OF KANSAS  
STATE CORPORATION COMMISSION

WELL PLUGGING RECORD

Give All Information Completely.  
Make Required Affidavit  
Mail or Deliver Report to:  
Conservation Division  
State Corporation Commission  
212 No. Market  
Wichita, Kansas.

NORTH

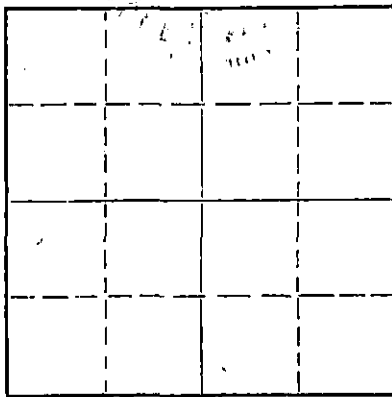

Locate well correctly on above  
Section Plat

Stafford County, Sec. 16 Twp. 22 Rge. 14 (E) (W) x  
Location as "NE/CNW/SW" or footage from lines. NW NW NE  
Lease Owner Monarch Oil & Gas Co.  
Lease Name Dralle Well No. A-1  
Office Address 1429 Wichita Plaza, Wichita, Kansas  
Character of Well (completed as Oil, Gas or Dry Hole)  
Date well completed 19  
Application for plugging filed 9-13-68 19  
Application for plugging approved 19  
Plugging commenced 9-27-68 19  
Plugging completed 9-30-68 19  
Reason for abandonment of well or producing formation  
If a producing well is abandoned, date of last production 19  
Was permission obtained from the Conservation Division or its agents before plugging was commenced?

Name of Conservation Agent who supervised plugging of this well Ralph Warren  
Producing formation Depth to top Bottom Total Depth of Well 3900' Feet  
Show depth and thickness of all water, oil and gas formations.

OIL, GAS OR WATER RECORDS

CASING RECORD

FORMATION	CONTENT	FROM	TO	SIZE	PUT IN	PULLED OUT
				4 1/2"	3675'	2912.59'
				8 5/8"	250'	

Describe in detail the manner in which the well was plugged, indicating where the mud fluid was placed and the method or methods used in introducing it into the hole. If cement or other plugs were used, state the character of same and depth placed, from feet to feet for each plug set.

Made bottom hole plug back with sand to 3575'. Mixed and ran 3 sacks cement thru dump bailer.  
Squeezed hole with 10 sacks gel - gel from 800' to 300', followed with 50 sacks cement. Cement from 300' to 150', followed with 5 sacks gel. Gel from 150' to 30, displaced with 10 sacks cement. Cement from 30' to base of cellar.

RECEIVED  
STATE CORPORATION COMMISSION  
OCT 2 - 1968  
CONSERVATION DIVISION  
Wichita, Kansas  
10-2-68

(If additional description is necessary, use BACK of this sheet)

Name of Plugging Contractor Southwest Casing Pulling Co.  
Address Box 364, Great Bend, Kansas

STATE OF Kansas, COUNTY OF Barton, ss.  
Southwest Casing Pulling Co. (employee of owner) or (owner or operator) of the above-described well, being first duly sworn on oath, says: That I have knowledge of the facts, statements, and matters herein contained and the log of the above-described well as filed and that the same are true and correct. So help me God.

(Signature) M. C. Spencer Sec.  
Box 364, Great Bend, Kansas  
(Address)

Subscribed and sworn to before me this 1 day of October, 1968



Sidney Miller  
Notary Public.