


WELL PLUGGING RECORD

Give All Information Completely
Make Required Affidavit
Mail or Deliver Report to:
Conservation Division
State Corporation Commission
800 Biting Building
Wichita, Kansas

Stafford County, Sec. 33 Twp. 23 Rge. 11 (E) W (W)

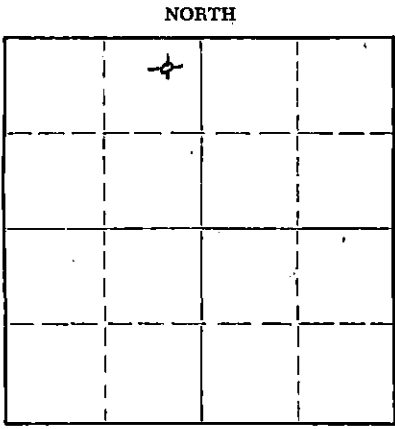

Locate well correctly on above Section Plat

Location as "NE/CNW/WSW" or footage from lines NE NE NW
Lease Owner J. G. Beard Estate, Emily Ruth Beard, Executrix
Lease Name Stalcup Well No. 1
Office Address 1300 Broadway, Oklahoma City, Oklahoma
Character of Well (completed as Oil, Gas or Dry Hole) Dry hole
Date well completed Oct. 15, 1955
Application for plugging filed Oct. 15, 1955
Application for plugging approved Oct. 15, 1955
Plugging commenced Oct. 15, 1955
Plugging completed Oct. 15, 1955
Reason for abandonment of well or producing formation Dry hole

If a producing well is abandoned, date of last production 19
Was permission obtained from the Conservation Division or its agents before plugging was commenced? Yes

Name of Conservation Agent who supervised plugging of this well Warren Horner
Producing formation _____ Depth to top _____ Bottom _____ Total Depth of Well 3784 Feet
Show depth and thickness of all water, oil and gas formations.

OIL, GAS OR WATER RECORDS

CASING RECORD

FORMATION	CONTENT	FROM	TO	SIZE	PUT IN	PULLED OUT
		0	162	8 5/8"	162	None

Describe in detail the manner in which the well was plugged, indicating where the mud fluid was placed and the method or methods used in introducing it into the hole. If cement or other plugs were used, state the character of same and depth placed, from _____ feet to _____ feet for each plug set.

From 3784' to 161 1/2' - heavy rotary mud
161 1/2' to 160' - wooden plug
160' to 98' - 20 sacks cement and 1/2 sack hulls
98' to 36 1/2' - heavy rotary mud
36 1/2' to 35' - wooden plug
35' to 6' - 15 sacks cement and 1/2 sack hulls
6' to surface - cellar

(If additional description is necessary, use BACK of this sheet)

Name of Plugging Contractor Glenn W. Peel
Address P.O. Box 359, Hoisington, Kansas

STATE OF KANSAS, COUNTY OF BARTON, ss.
Glenn W. Peel (employee of owner) or (owner or operator) of the above-described well, being first duly sworn on oath, says: That I have knowledge of the facts, statements, and matters herein contained and the log of the above-described well as filed and that the same are true and correct. So help me God. GLENN W. PEEL

(Signature) BY: [Signature]
P.O. Box 359, Hoisington, Kansas
(Address)

SUBSCRIBED AND SWORN TO before me this 19th day of October, 19 55

My commission expires June 4, 1959

RECEIVED Notary Public.
STATE CORPORATION COMMISSION

OCT 20 1955 10-20-55

CONSERVATION DIVISION
Wichita, Kansas

PLUGGING
FILE SEC. 33 T. 23 R. 11 W.
BOOK PAGE 9 LINE 32

DRILLERS' LOG

15-185-11979-0000

Company: J. G. Beard Estate

NE NE NW

Farm Name: Stalcup Well No. 1

Sec. 33, Twp. 23S, Rge. 11W,

Total Depth: 3784'

County: Stafford,
Kansas

Comm: 10-2-55 Comp: 10-15-55

Contractor: Glenn W. Peel

Elevation:

Casing: 8 5/8" 162' cem.

Production: Dry

Figures below indicate bottoms of formations:

Surface clay	0 -	20
Sand		90
Red bed and shale		163
Shale and shells		810
Anhydrite		848
Shale and shells		1685
Lime and shale		1850
Lime		1985
Shale and lime		2260
Shale and lime streaks		2455
Shale and lime		2890
Lime		3010
Lime and shale streaks		3080
Lime		3245
Shale and lime		3315
Lime		3560
Lime and shale		3587
Lime		3670
Cherty Lime		3690
Lime and shale		3755
Arbuckle		3784
Total Depth		3784

This is to certify that the above information is to the best of our knowledge, true and correct.

GLENN W. PEEL

BY: Wm Herbert

SUBSCRIBED AND SWORN to before me this 19th day of October, 1955

My commission expires: June 4, 1959

Marian McHerbert
Notary Public

PLUGGING
NE SEC 33 T23S R11W
BOOK PAGE 9 LINE 22

RECEIVED
STATE COURT
CONSENT DIVISION