

15-185-12687-0000

STATE OF KANSAS  
STATE CORPORATION COMMISSION

WELL PLUGGING RECORD


OR

~~FORMATION PLUGGING RECORD~~

Strike out upper line when reporting plugging of formations.

Give All Information Completely  
Make Required Affidavit  
Mail or Deliver Report to:  
Conservation Division  
State Corporation Commission  
800 Bitting Building  
Wichita, Kansas

NORTH

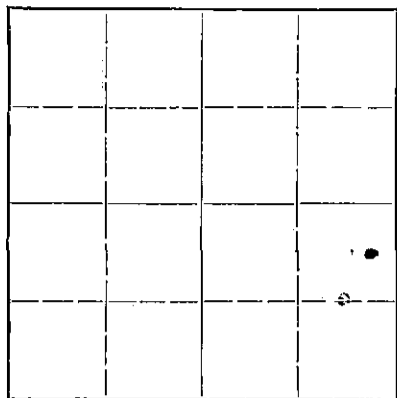

Locate well correctly on above Section Plat

Stafford County. Sec. 35 Twp. 23S Rge. (E) 11 (W) 11  
Location as "NE 1/4 NW 1/4 SW 1/4" or footage from lines NE SE 660' fm Nth, 330' fm East line  
Lease Owner. Sinclair Prairie Oil Co  
Lease Name. R. C. Ardrey Well No. 1  
Office Address. Box 521, Tulsa, Okla.  
Character of Well (completed as Oil, Gas or Dry Hole) oilwell  
Date well completed. May 31, 1945  
Application for plugging filed. Feb 12, 1949  
Application for plugging approved. Feb 15, 1949  
Plugging commenced. Apr. 21, 1949  
Plugging completed. Apr. 24, 1949  
Reason for abandonment of well or producing formation. Production depleted

If a producing well is abandoned, date of last production. March 18, 1949  
Was permission obtained from the Conservation Division or its agents before plugging was commenced? yes

Name of Conservation Agent who supervised plugging of this well. C.D. Stough  
Producing formation. Misener Depth to top. 3697 Bottom. Total Depth of Well. 3702 Feet  
Show depth and thickness of all water, oil and gas formations.

OIL, GAS OR WATER RECORDS

CASING RECORD

Formation	Content	From	To	Size	Put In	Pulled Out
Misener	dry	3697	3702	10-3/4	156'	0
				5-1/2	3742	3315'

Describe in detail the manner in which the well was plugged, indicating where the mud fluid was placed and the method or methods used in introducing it into the hold. If cement or other plugs were used, state the character of same and depth placed, from feet to feet for each plug set.

3702-3690' cmt 5sx  
3690- 214 mud  
214-210 rock bridge  
210-170 cmt 20 sx  
170- 0 mud & 10 sx cmt

4-30-49

RECEIVED  
APR 30 1949  
STATE CORPORATION COMMISSION  
KANSAS

(If additional description is necessary, use BACK of this sheet)

Correspondence regarding this well should be addressed to Mr. E.H. Gibbons  
Address. Box 551, Chase, Kans


STATE OF Kansas, COUNTY OF Rice, ss.  
I, E.H. Gibbons (employee of owner) or (conservation agent) of the above-described well, being first duly sworn on oath, says: That I have knowledge of the facts, statements, and matters herein contained and the log of the above-described well as filed and that the same are true and correct. So help me God.

(Signature) E.H. Gibbons

Box 551, Chase, Kans (Address)

SUBSCRIBED AND SWORN to before me this 28 day of April, 1949

My commission expires April 24, 1952 Notary Public.

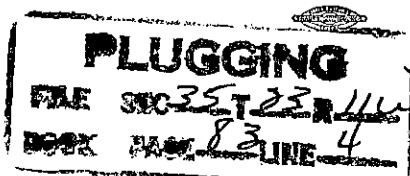

Well Log  
Sinclair Prairie Oil Co.

R.C. Ardrey # 1  
660' fm Nth 330' fm East lines.  
SE/4, 35-23-11W, Stafford Co., Kas.  
Elev. 1811'

Harbar Drilling Co-rotary  
Began drilling Mar. 29, 1945  
Completed drilling May 31, 1945  
Original TD 3708'  
Plugged back to 3702'

Drillers Log

Surface Soils-Sand	150
Shale	200
Sand & Shells	235
Red Bed	380
Red Bed & Shale	450
Sand & Shale	580
Shale & Shells	840
Anhydrite	950
Shale & Shells	1115
Lime & Shale	1205
Shale & Shells	1495
Lime	1600
Lime-broken	1690
Lime	1790
Lime-broken	1925
Lime	1995
Lime-broken	2055
Lime	2475
Shells & Shale	2550
Lime-Shells-Shale	2615
Shale & Shells	2838
Lime	3175
Lime & Shale	3690
Sand	3700
Lime	3871
Plugged back to	3749½
Top Topeka	2848
Top Lansing	3338
Top Misener	3697
Top Viola	3711
Simpson Sand	3832
PB-TD in Viola	3749½

10-3/4" set at 213' w/156 sx  
5-1/2" set at 3711' w/75 sx

No commercial oil show in K.C.  
Show oil, odor 3697-3709' Misener  
Show oil 3712-15' Viola  
August 1948 plugged back to 3702' to test Misner.  
Perf. Misener 53 holes 3693-3702' show gas  
Acidized 1000 gals. Completed for 5 or 6 bbl oil.

**RECEIVED**  
Conservation Div.  
FEB 18 1948  
STAFFORD COUNTY CORPORATION  
STAFFORD COUNTY, KANSAS

**PLUGGING**  
FILE SEC 35-23-11W  
BOOK PAGE 83 LINE 4