


15-185-17686-0000

STATE OF KANSAS
STATE CORPORATION COMMISSION

Give All Information Completely
Make Required Affidavit
Mail or Deliver Report to:
Conservation Division
State Corporation Commission
211 No. Broadway
Wichita, Kansas

WELL PLUGGING RECORD

T - 23S NORTH R - 11W

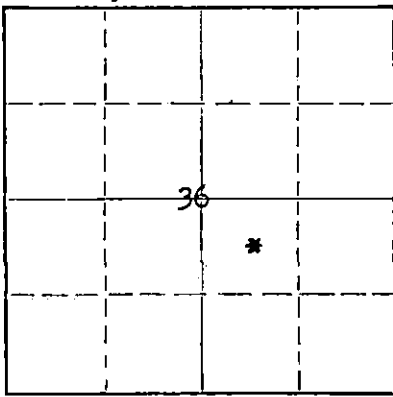

Locate well correctly on above
Section Plat

Stafford County, Sec. 36 Twp. 23S Rge. 11W (E) (W)
Location as "NE/CNW/SW" or footage from lines CNW SE
Lease Owner Frank J. Black
Lease Name C.M. Krey Well No. 3
Office Address Box 150, McPherson, Kansas
Character of Well (completed as Oil, Gas or Dry Hole) Oil
Date well completed 11-7 1943
Application for plugging filed 6-5 1958
Application for plugging approved 6-6 1958
Plugging commenced 6-10 1958
Plugging completed 6-14 1958
Reason for abandonment of well or producing formation Unprofitable

If a producing well is abandoned, date of last production 19
Was permission obtained from the Conservation Division or its agents before plugging was commenced? Yes

Name of Conservation Agent who supervised plugging of this well Frank Broadfoot
Producing formation _____ Depth to top _____ Bottom _____ Total Depth of Well 3725 Feet
Show depth and thickness of all water, oil and gas formations.

OIL, GAS OR WATER RECORDS

CASING RECORD

| FORMATION | CONTENT | FROM | TO | SIZE | PUT IN | PULLED OUT |
|-----------|---------|------|----|--------|--------|------------|
| | | | | 9" | 335' | None |
| | | | | 5 1/2" | 3697' | 1628.45' |
| | | | | | | |
| | | | | | | |
| | | | | | | |
| | | | | | | |
| | | | | | | |
| | | | | | | |
| | | | | | | |

Describe in detail the manner in which the well was plugged, indicating where the mud fluid was placed and the method or methods used in introducing it into the hole. If cement or other plugs were used, state the character of same and depth placed, from _____ feet to _____ feet for each plug set.

Run sand from 3725' to 3690'

Run 5 sks. cement at 3690'

Mud to 240' and set with rock bridge

Run 20 sks. cement

Mud to 15' and set with rock bridge

Run 10 sks. cement to cellar base

Work completed 6-14-58

RECEIVED
STATE CORPORATION COMMISSION

JUN 24 1958

CONSERVATION DIVISION
Wichita, Kansas

(If additional description is necessary, use BACK of this sheet)

Name of Plugging Contractor Morgan Well Plugging Service
Address 102 West Eighteenth, Hutchinson, Kansas

6-24-58

STATE OF KANSAS, COUNTY OF MCPHERSON, ss.

(employee of owner) or (owner or operator) of the above-described well, being first duly sworn on oath, says: That I have knowledge of the facts, statements, and matters herein contained and the log of the above-described well as filed and that the same are true and correct. So help me God.

(Signature) *[Handwritten Signature]*

SUBSCRIBED AND SWORN TO before me this 23 day of June, 1958

My commission expires June 10, 1961 *[Handwritten Signature]* Notary Public.

PLUGGING
FILE SEC 36 T 23 R 11W
BOOK PAGE 106 LINE 5

15-185-17686-0000

WELL LOG BUREAU -- KANSAS GEOLOGICAL SOCIETY
412 Union National Bk. Bldg., Wichita, Kansas

Company - TRANSWESTERN OIL CO.
Farm - C.M. Krey No. 3.


SEC. 36
C1W SE

T. 23

R. 11

Total Depth. 3725'
Comm. 10-18-43 Comp. 11-7-43
Shot or Treated.
Contractor.
Issued. 1-22-44

County. Stafford
KANSAS

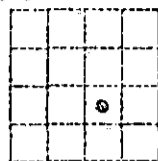

Elevation.

Production. Pot. 3000 B.

CASING:
9" 335' Cem.
5 1/2" 3697' Cem.

Figures Indicate Bottom of Formations.

| | |
|--------------------|----------|
| clay & sand | 0-125 |
| shale & shells | 220 |
| red rock | 240 |
| red bed | 300 |
| shells | 340 |
| red rock | 485 |
| anhydrite | 518 |
| shale & shells | 1030 |
| salt | 1285 |
| shale & shells | 1345 |
| lime brkn | 1495 |
| lime & shale | 1580 |
| lime brkn | 1620 |
| sand sharp | 1905 |
| lime | 2050 |
| lime & shale | 2860 |
| lime | 3120 |
| lime & shale | 3350 |
| lime | 3425 |
| lime w/sdy strks | 3465 |
| lime & shale | 3586 |
| lime | 3620 |
| lime & tough shale | 3660 |
| shale | 3675 |
| Misener sand | 3685 |
| shale | 3694 |
| lime | 3721 |
| lime & chert | 3723 1/2 |
| dolomite & chert | 3725 |
| Total Depth. | |

| | | |
|-------|----------|------|
| Tops: | Iansing | 3317 |
| | Misener | 3672 |
| | Viola | 3801 |
| | Chert | 3724 |
| | Dolomite | 3721 |

RECEIVED
STATE CORPORATION COMMISSION
JUN 6 1958
CONSERVATION DIVISION
Wichita, Kansas

PLUGGING
FILE SEC 36 T 23 R 11W
BOOK PAGE 106 LINE 5