


15-185-12651-0600

WELL PLUGGING RECORD

Give All Information Completely
Make Required Affidavit
Mail or Deliver Report to:
Conservation Division
State Corporation Commission
211 No. Broadway
Wichita, Kansas

NORTH

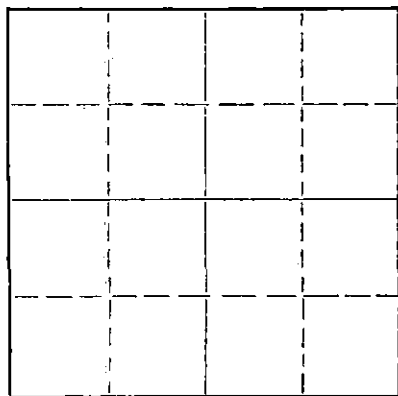

Locate well correctly on above
Section Plat

Stafford County. Sec. 36 Twp. 23S Rge. (E) 11 (W)
Location as "NE/CNW/SW" or footage from lines C E/2 SW NE
Lease Owner Sunray Mid-Continent Oil Company
Lease Name Volker A Well No. 2
Office Address Box # 788, Great Bend, Kansas
Character of Well (completed as Oil, Gas or Dry Hole) Oil
Date well completed April 7, 1944
Application for plugging filed February 26, 1957
Application for plugging approved February 27, 1957
Plugging commenced February 27, 1957
Plugging completed March 3, 1957
Reason for abandonment of well or producing formation Reached Economic Limit
If a producing well is abandoned, date of last production November 13, 1956
Was permission obtained from the Conservation Division or its agents before plugging was commenced? Yes

Name of Conservation Agent who supervised plugging of this well R. M. Brundage
Producing formation _____ Depth to top _____ Bottom _____ Total Depth of Well 3722 Feet
Show depth and thickness of all water, oil and gas formations.

OIL, GAS OR WATER RECORDS

CASING RECORD

FORMATION	CONTENT	FROM	TO	SIZE	PUT IN	PULLED OUT
				9 5/8"	295'	None
				5 1/2"	3702'	3006'

Describe in detail the manner in which the well was plugged, indicating where the mud fluid was placed and the method or methods used in introducing it into the hole. If cement or other plugs were used, state the character of same and depth placed, from _____ feet to _____ feet for each plug set.

Filled hole with sand from 3722' to 3690',
ran 5 sack cement. Pulled csg to 1400',
pumped in 10 sacks jell mud. Pull rest of
csg. Mudded hole to 270', set 10' rock bridge
ran 20 sacks cement. Bailed off fluid. Mudded
hole to 20', set rock bridge, ran 5 sacks
cement on top. Pluggin completed.

Well log attached.

RECEIVED
STATE CORPORATION COMMISSION

MAR 6 1957

CONSERVATION DIVISION
Wichita, Kansas

(If additional description is necessary, use BACK of this sheet)

Name of Plugging Contractor West Supply Co., Inc.
Address Chase, Kansas

STATE OF KANSAS, COUNTY OF BARTON, ss.
N. E. Montgomery (employee of owner) or (~~owner or operator~~) of the above-described well, being first duly sworn on oath, says: That I have knowledge of the facts, statements, and matters herein contained and the log of the above-described well as filed and that the same are true and correct. So help me God.

(Signature) N. E. Montgomery
Box # 788, Great Bend, Kansas
(Address)

SUBSCRIBED AND SWORN TO before me this 5 day of March, 1957

Notary Public
Notary Public.

My commission expires Dec. 24, 1960

PLUGGING
FILE SEC 36 T. 23 R. 11W
BOOK PAGE 144 LINE 4

VOLKER A # 2

Sunray Mid-Continent Oil Co.
C E/2 SW NE
Sec. 36-23-11
Stafford County, Kansas

15-185-12651-0000

<u>FORMATION</u>	<u>DEPTH</u>
Sand & Clay	160
Lime & Shale	170
Sand & Lime	265
Red Bed	295
Red Rock	460
Anhydrite	492
Shales & Shales	801
Shale & Lime	1082
Shale	1100
Salt	1250
Shale & Lime	1398
Lime and Shale Streaks	1468
Lime & Little Shale	1554
Lime	1617
Grey Lime	1675
Broken Lime	1723
Grey Lime & Little Shale	1829
Lime and Shale	1872
Lime and Shale Streaks	1970
Lime and Shale	2105
Shale & Shells	2512
Shale & Lime	2512
Lime and Shale	2604
Shale & Lime Streaks	2727
Shale Sand & Lime	2848
Lime	3116
Shale & Lime	3278
Shale & Lime	3295
Lime	3352
Shale & Lime	3369
Cherty Lime	3400
Lime & Chert	3430
Lime & Shale	3455
Lime	3505
Broken Lime	3523
Broken Lime	3557
Lime	3610
Shale & Lime	3648
Lime & Shale	3667
Sand	3676
Shale	3678
Shale & Lime	3698
Lime	3705
Chert Hard	3707
Chert Hard	3709
Chert Soft	3713

RECEIVED
STATE CORPORATION COMMISSION

MAR 6 - 1960

CONSERVATION DIVISION
Wichita, Kansas

I, N. E. Montgomery, do hereby certify that the above is a true and complete log of the Sunray Mid-Continents Volker A #2 located C E/2 SW NE, Sec. 36-23-11, Stafford County, Kansas

N. E. Montgomery
[Signature]
Notary Public

My comm expires
Dec. 24, 1960

PLUGGING
FILE SEC. 36 T. 23 R. 11
BOOK PAGE 144 LINE 4