

15-185-12649-0000

STATE OF KANSAS  
STATE CORPORATION COMMISSION

WELL PLUGGING RECORD

Give All Information Completely  
Make Required Affidavit  
Mail or Deliver Report to:  
Conservation Division  
State Corporation Commission  
800 Bitling Building  
Wichita, Kansas


FORMATION PLUGGING RECORD

Strike out upper line  
when reporting plug-  
ging off formations.

Reno County, Sec. 36 Twp. 23 Rge. 11 (E) W. (W)

Location as "NE $\frac{1}{4}$ NW $\frac{1}{4}$ SW $\frac{1}{4}$ " or footage from lines  
Lease Owner Sunray Oil Corp.  
Lease Name Krey Well No. 4  
Office Address Great Bend, Kansas  
Character of Well (completed as Oil, Gas or Dry Hole) Oil Well  
Date well completed 19  
Application for plugging filed 19  
Application for plugging approved 19  
Plugging commenced 5-7 19 48  
Plugging completed 5-18 19 48  
Reason for abandonment of well or producing formation Depleted

NORTH

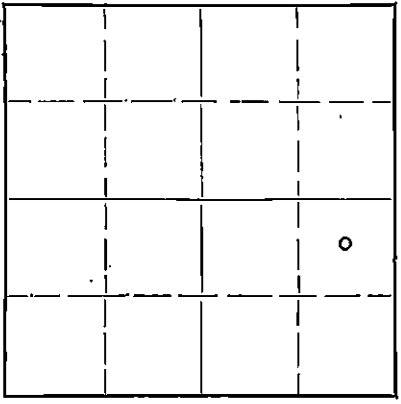

Locate well correctly on above  
Section Plat

If a producing well is abandoned, date of last production 19  
Was permission obtained from the Conservation Division or its agents before plugging was com-  
menced? Yes

Name of Conservation Agent who supervised plugging of this well Petty  
Producing formation Arbuckle Depth to top Bottom Total Depth of Well 3756 Feet  
Show depth and thickness of all water, oil and gas formations.

OIL, GAS OR WATER RECORDS

CASING RECORD

Formation	Content	From	To	Size	Put In	Pulled Out
				13 1/2	334	Left In
				5 1/2	3701	3058.65

Describe in detail the manner in which the well was plugged, indicating where the mud fluid was placed and the method or methods used in introducing it into the hole. If cement or other plugs were used, state the character of same and depth placed, from feet to feet for each plug set.

3756 Total depth  
3756 - 3700 Mud 5 Sack Cement  
3700 - 334 Mud 25 Sack Cement  
334 - 20 Mud  
20 - 0 20 Sack Cement

5-27-48

(If additional description is necessary, use BACK of this sheet)

Correspondence regarding this well should be addressed to  
Address

STATE OF Kansas, COUNTY OF Reno, ss.

Walker & Dowell Serv. Co. (employee of owner) or (owner or operator) of the above-described well,  
being first duly sworn on oath, says: That I have knowledge of the facts, statements, and matters herein contained and the log of the above-described well as filed and that the same are true and correct. So help me God.

(Signature) Walker & Dowell Serv. Co. By H.M. Walker  
Box 313  
Hutchinson, Kansas (Address)

SUBSCRIBED AND SWORN to before me this MAY 25 1948 day of

[Signature]  
Notary Public.

My commission expires June 23, 1951

My commission expires

PLUGGING  
FILE SEC 36 T23 R11W  
BOOK PAGE 23 LINE 40

Sunray Oil Corporation

15-185-12649-0000

KREY #4  
 C-E/2 NE SE  
 Sec. 36-23-11W  
 Stafford County, Kansas.

LOG:

Clay	20
Sand	95
Sand & Clay	340
Red bed	480
Anhydrite	505
Shale	675
Shale	1000
Salt	1275
Broken Lime	1580
Lime	1772
Sandy Lime	1940
Lime	2026
Lime & shale	2182
Lime & shale	2200
Shale & lime	2343
Broken lime	2470
Lime w/shale streaks	2615
Broken Lime	2730
Lime & shale	2822
Lime	2839
Lime	2880
Lime	2943
Lime	3012
Lime w/streaks of brokn lime	3094
Lime	3145
Lime & shale	3185
Broken lime	3205
Lime & shale	3224
Lime & shale	3290
Lime & shale	3350
Shale & lime	3380
Lime w/cherty & sandy streaks	3423
Chert	3437
Chert Hard & Rough	3448
Chert & Lime	3454
Chert & lime	3570
Lime	3593
Lime	3655
Lime & shale	3680
Misner Sand	3686
Shale	3688
Shale (Sandy)	3691
Shale	3699
Lime (Dolomite-Show)	3701
Xyln Lime (TD w/rotary)	3703
Cement shoe & lime (NoShow)	3707
Lime & chert (Slight stain)	3710
Chert	3717
Gas & Oil--Lime & Chert	3724
More gas--Well Started spray oil	3727
More gas & more oil	3730
Hard Total Depth	3731

Top of the KC Lime 3309'

Top of the Misner Sand 3680-86'

Top of the Viola Lime 3699'

