


WELL PLUGGING RECORD

Give All Information Completely  
Make Required Affidavit  
Mail or Deliver Report to:  
Conservation Division  
State Corporation Commission  
800 Bitting Building  
Wichita, Kansas

NORTH

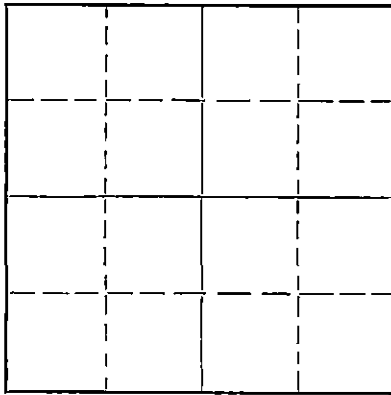

Locate well correctly on above  
Section Plat

Stafford County. Sec. 36 Twp. 23. Rge. (E) 11 (W)  
Location as "NE/CNW $\frac{1}{4}$ SW $\frac{1}{4}$ " or footage from lines C-SW SE  
Lease Owner Sunray Oil Corporation  
Lease Name Krey Well No. 2  
Office Address Box 195, Great Bend, Kansas  
Character of Well (completed as Oil, Gas or Dry Hole) Oil  
Date well completed 10-18 19 43  
Application for plugging filed 4-3 19 52  
Application for plugging approved 4-4 19 52  
Plugging commenced 4-3 19 52  
Plugging completed 4-8 19 52  
Reason for abandonment of well or producing formation Production had decreased  
until it was no longer profitable to operate well  
If a producing well is abandoned, date of last production 2-10 19 52  
Was permission obtained from the Conservation Division or its agents before plugging was commenced? Yes

Name of Conservation Agent who supervised plugging of this well Merle Rives  
Producing formation Viola Depth to top 3701' Bottom 3737' Total Depth of Well 3737' Feet  
Show depth and thickness of all water, oil and gas formations.

OIL, GAS OR WATER RECORDS

CASING RECORD

Formation	Content	From	To	Size	Put In	Pulled Out
Lsg-KC	Dry	3316		9" OD	332'	None
Misner Sand	Dry	3683	3693	5 $\frac{1}{2}$ "	3703'	3125'
Viola	Oil	3701	3737			

Describe in detail the manner in which the well was plugged, indicating where the mud fluid was placed and the method or methods used in introducing it into the hole. If cement or other plugs were used, state the character of same and depth placed, from feet to feet for each plug set.

Sanded hole from 3737' to 3695', and ran 5 sax of cement. Bailed hole.  
Mudded hole to 250', set 10' rock bridge and ran 20 sax of cement. Mudded  
hole to 30', set rock bridge and ran 10 sax of cement on top. Plugging  
completed.

4-17-52

(If additional description is necessary, use BACK of this sheet)

Correspondence regarding this well should be addressed to Sunray Oil Corporation  
Address Box 195, Great Bend, Kansas

STATE OF KANSAS, COUNTY OF BARTON, ss.  
W. E. Westbrook, Jr. (employee of owner) of the above-described well,  
being first duly sworn on oath, says: That I have knowledge of the facts, statements, and matters herein contained and the log of the above-described well as filed and that the same are true and correct. So help me God.


(Signature) W. E. Westbrook, Jr. Jr. Engineer  
Box 195, Great Bend, Kansas  
(Address)

SUBSCRIBED AND SWORN TO before me this 15th day of April, 19 52.

Martha Scott  
Notary Public.

My commission expires 4-19-52

23-3273-s 4-50-10M

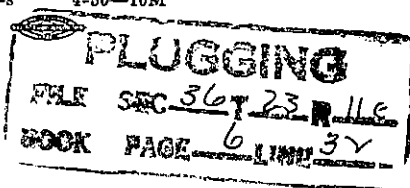

15-185-12648-0500

#2 Krey  
Sunray Oil Corporation  
C-SW SE Sec. 36-23-11W  
Stafford County, Kansas

<u>Formation</u>	<u>Depth</u>
Sand	90'
Red bed & shale	250
Red bed	345
Shale & Red bed	480
Anhydrite	505
Shale & shells	1025
Salt	1275
Shale & shells	1635
Lime & sandy streaks	1800
Broken lime & sand	1920
Lime & shale	2810
Broken lime	2910
Topeka lime	2975
Lime	3030
Lime & shale	3341
Lime	3440
Lime w/sandy streaks	3465
Lime & soft spots	3512
Lime	3610
Lime & shale	3685
Sand	3696
Sand	3703
Viola Lime	3710
Correct back for rotary table minus 2'	
Hard lime	3709
Lime & chert	3714
1st Oil & Gas	3719
Some saturation & Porosity	3723
Slight stain	3727
Some saturation	3731 $\frac{1}{2}$
Pay Zone - Saturation	3737 TD

STATE OF KANSAS )  
                          ) ss  
COUNTY OF BARTON )

**PLUGGING**  
FILE SEC 36-23-11W  
BOOK PAGE LINE 3v

I, W. E. Westbrook, Jr., do hereby certify that the above is a true and correct log of the above captioned well to the best of my knowledge.

APR 17 1952

W. E. Westbrook, Jr.  
Jr. Engineer

Subscribed and sworn to before me this 15th day of April, 1952

Martha Scott  
Notary Public

My Commission Expires: April 19, 1952