


B-185-12647-0000

STATE OF KANSAS
STATE CORPORATION COMMISSION

WELL PLUGGING RECORD

Give All Information Completely
Make Required Affidavit
Mail or Deliver Report to:
Conservation Division
State Corporation Commission
800 Bittling Building
Wichita, Kansas

NORTH

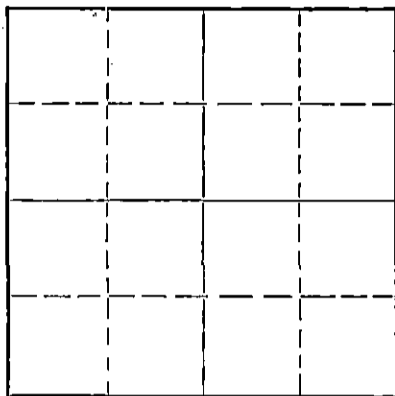

Locate well correctly on above
Section Plat

Stafford County. Sec. 36 Twp. 23 Rge. 11 (E) W. (W)
Location as "NE/CNW $\frac{1}{4}$ SW $\frac{1}{4}$ " or footage from lines E/2 NE/4 SW/4
Lease Owner Republic Natural Gas Company
Lease Name O. Volker Well No. 1
Office Address Box 126, Ellinwood, Kansas
Character of Well (completed as Oil, Gas or Dry Hole) Oil
Date well completed January 21 1944
Application for plugging filed August 18 1950
Application for plugging approved August 19 1950
Plugging commenced August 28 1950
Plugging completed September 4 1950
Reason for abandonment of well or producing formation Formation quit
producing oil.
If a producing well is abandoned, date of last production January 24 1950
Was permission obtained from the Conservation Division or its agents before plugging was commenced? Yes

Name of Conservation Agent who supervised plugging of this well C. D. Stough
Producing formation Viola Depth to top 3690 Bottom 3721 Total Depth of Well 3721 Feet
Show depth and thickness of all water, oil and gas formations.

OIL, GAS OR WATER RECORDS

CASING RECORD

Formation	Content	From	To	Size	Put In	Pulled Out
Surface Csg.		Surface	283'	13"OD	283'	None
Oil String Csg.		Surface	3717'	7"OD	3717'	3027'
Misner	Water	3671'	3690'			
Viola	Oil	3690'	3721'			

Describe in detail the manner in which the well was plugged, indicating where the mud fluid was placed and the method or methods used in introducing it into the hole. If cement or other plugs were used, state the character of same and depth placed, from _____ feet to _____ feet for each plug set.

Lane-Wells bridging plug set @ 3425'
3425' to 3400' - Rock
3400' to 3365' - Cement, 6 sacks
3365' to 290' - Heavy Mud
290' to 280' - Rock
280' to 255' - Cement, 20 sacks
255' to 15' - Mud
15' to 10' - Rock
10' to 0' - Cement to top of surface pipe, 10 sacks

(If additional description is necessary, use BACK of this sheet)

Correspondence regarding this well should be addressed to Republic Natural Gas Company
Address Box 126, Ellinwood, Kansas

STATE OF Kansas, COUNTY OF Barton, ss.
H. E. Wolfe (employee of owner) or (owner or operator) of the above-described well,
being first duly sworn on oath, says: That I have knowledge of the facts, statements, and matters herein contained and the log of the above-described well as filed and that the same are true and correct. So help me God.

(Signature) *H. E. Wolfe*
Box 126, Ellinwood, Kansas (Address)

SUBSCRIBED AND SWORN to before me this 11th day of September, 1950

My commission expires 7-25-51

28-8273-s 4-50-10M

PLUGGING
FILE SEC. 36, T. 23, R. 11, W. 11
CORR. PAGE 22, LINE 23

L. Yvonne M. Stevenson
Notary Public.
SEP 12 1950 9-12-50

DRILLING LOG

15-185-12647-0000

REPUBLIC NATURAL GAS COMPANY

Lease O. Volker

Well No. #1

Total Depth 3721'

County Stafford

Sec. 36 Twp. 23 Rge 11

Location E/2 NE/4 SW/4

Elevation 1808'

0 - 50'	Surface Sand	3569 - 3645'	Lime & Shale
50 - 175'	Red Bed	3645 - 3675'	Lime Shale
175 - 300'	Shale & Shells, Measurement Corr.	3675 - 3700'	Lime Shale
260 - 280'	Cement	3700' -	Set 7" OD casing @ 3700'
280 - 720'	Shale & Shells	3700 - 3705'	Lime
720 - 1080'	Shale & Shells	3705 - 3721'	Chert
1080 - 1432'	Shale & Shells	3721'	T.D.
1432 - 1530'	Shale & Lime		
1530 - 1645'	Sand & Lime		
1645 - 1745'	Lime		
1745 - 1845'	Lime & Shale		
1845 - 1865'	Shale Lime		
1865 - 1948'	Lime		
1948 - 2020'	Lime		
2020 - 2110'	Shale		
2110 - 2180'	Shale		
2180 - 2355'	Shale		
2355 - 2405'	Shale Lime		
2405 - 2505'	Shale		
2505 - 2610'	Shale		
2610 - 2735'	Shale		
2735 - 2830'	Broken Lime		
2830 - 2895'	Lime		
2895 - 2960'	Lime		
2960 - 3026'	Lime		
3026 - 3085'	Lime		
3085 - 3146'	Lime		
3146 - 3157'	Lime		
3157 - 3215'	Lime & Shale		
3215 - 3292'	Lime		
3292 - 3364'	Lime		
3364 - 3420'	Lime		
3420 - 3426'	Lime		
3426 - 3440'	Chert-Rough		
3440 - 3449'	Lime		
3449 - 3522'	Lime & Shale		
3522 - 3569'	Lime Shale		

Oct 12 1951

Records

PLUGGING
 FILE SEC 36 T 22 R 114
 BOOK PAGE 22 LINE 23