

WELL PLUGGING RECORD

Give All Information Completely
Make Required Affidavit
Mail or Deliver Report to:
Conservation Division
State Corporation Commission
212 North Market, Insurance Bldg.
Wichita, Kansas

Stafford County, Sec. 17 Twp. 22 Rge. 12 ~~22E~~ (W)

Location as "NE/CNW/SW" or footage from lines NW NE SE

Lease Owner E. K. Edmiston

Lease Name Stargel Well No. 1

Office Address 802 Union National Bldg.

Character of Well (completed as Oil, Gas or Dry Hole) dry hole

Date well completed December 30 19 60

Application for plugging filed December 29 19 60

Application for plugging approved December 29 19 60


Plugging commenced December 29 19 60

Plugging completed December 30 19 60

Reason for abandonment of well or producing formation commercial quantities of oil not present

If a producing well is abandoned, date of last production 19

Was permission obtained from the Conservation Division or its agents before plugging was commenced? yes

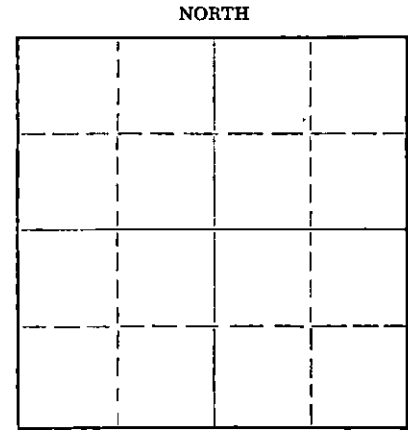

Locate well correctly on above Section Plat

Name of Conservation Agent who supervised plugging of this well

Producing formation Depth to top Bottom Total Depth of Well 3699 Feet

Show depth and thickness of all water, oil and gas formations.

OIL, GAS OR WATER RECORDS

CASING RECORD

FORMATION	CONTENT	FROM	TO	SIZE	PUT IN	PULLED OUT
				10 3/4"	276'	none

Describe in detail the manner in which the well was plugged, indicating where the mud fluid was placed and the method or methods used in introducing it into the hole. If cement or other plugs were used, state the character of same and depth placed, from feet to feet for each plug set.

Hymud 250' plug and 30 sks cement through drill pipe

Hymud to 35 feet, plug 1/2 sk hulls Bridge & 10 sacks cement

RECEIVED
STATE CORPORATION COMMISSION

MAR 29 1961

CONSERVATION DIVISION
Wichita, Kansas

3-29-61

(If additional description is necessary, use BACK of this sheet)

Name of Plugging Contractor E. K. Edmiston Drilling Co., Inc.

Address 802 Union National Bldg., Wichita, Kansas

STATE OF KANSAS, COUNTY OF SEDGWICK, ss. E. K. Edmiston (employee of owner) or (owner or operator) of the above-described well, being first duly sworn on oath, says: That I have knowledge of the facts, statements, and matters herein contained and the log of the above-described well as filed and that the same are true and correct. So help me God.

(Signature) [Signature]

802 Union National Bldg., Wichita, Kansas (Address)

SUBSCRIBED AND SWORN TO before me this 27th day of March, 19 61

My commission expires June 25, 1964

[Signature] Frances Marler Notary Public.



COMPANY:

E. K. Edmiston
802 Union National Bldg.
Wichita 2, Kansas

Rotary Drilling Commenced:

December 19, 1960

Rotary Drilling Completed:

December 30, 1960

Well Name:

Stargel #1
NW NE SE 17-22-12
Stafford County, Kansas

Contractor

E. K. Edmiston Drilling Co., Inc.
802 Union National Bldg.
Wichita, Kansas

Casing Record:

276' 10 3/4" w/ 225 sacks

LOG

Surface soil	0	-	46
Shale & sand			150
Shale			758
Anhydrite			780
Shale & shells			1085
Shale & lime			1597
Lime			2050
Shale & lime			2560
Lime & shale			3223
Lime			3280
Lime & shale			3353
Lime			3963
Arbuckle			3699 Rotary total depth

RECORDED
STATE CORPORATION
MAR 29 1961
CONSERVATION DIVISION
Wichita, Kansas

The undersigned, E. K. Edmiston, President of the E. K. Edmiston Drilling Company, Inc. hereby certifies, in behalf of said company that the above log is a true and correct log of the formations encountered in drilling the above well as reflected by the Daily Drilling Reports.

E. K. EDMISTON DRILLING COMPANY, INC.

By E. K. Edmiston
E. K. Edmiston President

STATE OF KANSAS)
COUNTY OF SEDGWICK } SS

BE IT REMEMBERED THAT, on this 27th day of March, 1961, before me, the undersigned, a Notary Public duly commissioned in and for the State and County aforesaid, came E. K. Edmiston, known to me to be the same person who executed the foregoing instrument as President and in behalf of the E. K. Edmiston Drilling Company, Inc. and he duly acknowledged the execution of the same for himself and for said company.

IN WITNESS WHEREOF, I have hereunto set my hand and official seal on the day and year last above written.

Frances Marler
Frances Marler Notary Public

My commission expires:
June 25, 1964