

STATE OF KANSAS  
STATE CORPORATION COMMISSION

WELL PLUGGING RECORD

Give All Information Completely  
Make Required Affidavit  
Mail or Deliver Report to:  
Conservation Division  
State Corporation Commission  
212 North Market, Insurance Bldg.  
Wichita, Kansas

Stafford County. Sec. 17 Twp. 22 Rge. 12 (E) W (W)

Location as "NE/CNW/SW" or footage from lines E 1/2 - SE - NE

Lease Owner E. K. Edvinstan Oil Co.

Lease Name Milam

Well No. 1

Office Address 802 Union Nat. Bank Bldg. Wichita 2, Kansas

Character of Well (completed as Oil, Gas or Dry Hole) Oil

Date well completed 6-17 1960

Application for plugging filed 9-12 1961

Application for plugging approved 9-12 1961


Plugging commenced 9-12 1961

Plugging completed 9-25 1961

Reason for abandonment of well or producing formation Depleting oil production & increasing water production, made it impossible to operate at a profit.

If a producing well is abandoned, date of last production 1-31 1961

Was permission obtained from the Conservation Division or its agents before plugging was commenced? Yes

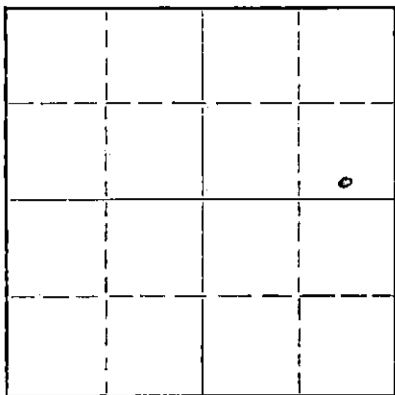

Locate well correctly on above Section Plat

Name of Conservation Agent who supervised plugging of this well Frank Broadfoot

Producing formation Arb Depth to top 3692 Bottom Not drilled Total Depth of Well 3700 Feet

Show depth and thickness of all water, oil and gas formations.

OIL, GAS OR WATER RECORDS

CASING RECORD

FORMATION	CONTENT	FROM	TO	SIZE	PUT IN	PULLED OUT
<u>Sand, shale &amp; sand</u>	<u>water</u>	<u>40'</u>	<u>250'</u>	<u>8"</u>	<u>272'</u>	<u>None</u>
<u>lime</u>	<u>oil &amp; water</u>	<u>3692'</u>	<u>3700'</u>	<u>4 1/2"</u>	<u>3693'</u>	<u>2845'</u>

Describe in detail the manner in which the well was plugged, indicating where the mud fluid was placed and the method or methods used in introducing it into the hole. If cement or other plugs were used, state the character of same and depth placed, from \_\_\_\_\_ feet to \_\_\_\_\_ feet for each plug set.

Run sand, 3700' to 3680'. Run 4 sacks of cement, 3680' to 3560'. Loaded hole with mud 3560' to 250'. Set rock bridge, run 2 bails of cement & let set. Bailed hole dry, ran 20 sacks of cement, 250' to 185'. Filled w/ mud to 40' & filled to bottom of collar with cement.

RECEIVED  
STATE CORPORATION COMMISSION

OCT 11 1961

CONSERVATION DIVISION  
Wichita, Kansas

10-11-61

(If additional description is necessary, use BACK of this sheet)

Name of Plugging Contractor Morgan Well Plugging Service

Address 731 - 15th Circle, Hutchinson, Kansas

STATE OF Kansas, COUNTY OF Barton, ss.  
Jack A. Perkins (employee of owner) or (owner or operator) of the above-described

well, being first duly sworn on oath, says: That I have knowledge of the facts, statements, and matters herein contained and the log of the above-described well as filed and that the same are true and correct. So help me God.

(Signature) Jack A. Perkins  
Jack A. Perkins  
3219 17th, Great Bend, Kansas  
(Address)

SUBSCRIBED AND SWORN TO before me this 3rd day of October, 1961

My commission expires June 15, 1964

Helen Steincamp  
Helen Steincamp  
Notary Public.



COMPANY:

E. K. Edmiston  
802 Union National Bldg.  
Wichita 2, Kansas

Rotary Drilling Commenced:

May 28, 1960

Rotary Drilling Completed:

June 7, 1960

WELL NAME:

MILAM No. 1  
C S/2 SE NE 17-22-12W  
Stafford County, Kansas

Contractor:

E. K. Edmiston Drilling Co., Inc.  
802 Union National Bldg.  
Wichita, Kansas

Casing Records:

8 5/8" @ 272' w/225 sacks  
3693' 4 1/2" w/100 sacks

LOG

Measurements from top of Rotary Bushings:

Sand	0	-	272
Shale	272	-	680
Shale & Red Bed			800
Shale & shells			1250
Lime & Shale			1570
Lime & Shale			1725
Lime			1940
Lime & Shale			1995
Shale & Lime			2040
Shale & Lime			3006
Lime & Shale			3200
Lime			3583
Viola			3631
Shale - Simpson			3686
Lime			3700 Rotary Total
			Depth


RECEIVED  
STATE CORPORATION COMMISSION

OCT 22 1961

CONSERVATION DIVISION  
Wichita, Kansas

The undersigned, E. K. Edmiston, President of the E. K. Edmiston Drilling Company, Inc., hereby certifies, in behalf of said company that the above log is a true and correct log of the formations encountered in drilling the above well as reflected by the Daily Drilling Reports.

E. K. Edmiston Drilling Company, Inc.

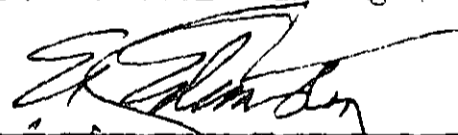By   
E. K. Edmiston President

STATE OF KANSAS )  
 ) ss.  
COUNTY OF SEDGWICK )

BE IT REMEMBERED that, on this 30th day of June, 1960, before me, the undersigned, a Notary public duly commissioned in and for the State and County aforesaid, came E. K. Edmiston, known to me to be the same person who executed the foregoing instrument, as President and in behalf of the E. K. Edmiston Drilling Company, Inc. and he duly acknowledged the execution of the same for himself and for said company.

IN WITNESS WHEREOF, I have hereunto set my hand and official seal on the day and year last above written.

  
Frances Marler Notary Public

My Commission Expires:

June 25, 1964