


WELL PLUGGING RECORD

Give All Information Completely  
Make Required Affidavit  
Mail or Deliver Report to:  
Conservation Division  
State Corporation Commission  
211 No. Broadway  
Wichita, Kansas

Stafford County, Sec. 17 Twp. 22S Rge. 12 (E) W (W)

Location as "NE/CNW/SW" or footage from lines C NE NE SW  
Lease Owner R. W. Shields  
Lease Name Teichmann Well No. 1  
Office Address Rule Building, Wichita, Kansas  
Character of Well (completed as Oil, Gas or Dry Hole) Dry Hole  
Date well completed July 26, 1957  
Application for plugging filed July 26, 1957  
Application for plugging approved July 26, 1957  
Plugging commenced July 26, 1957  
Plugging completed July 26, 1957  
Reason for abandonment of well or producing formation Dry Hole

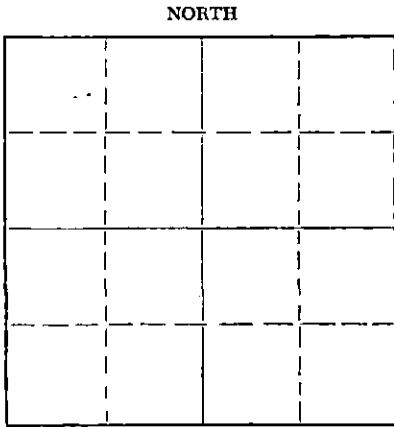

Locate well correctly on above Section Plat

If a producing well is abandoned, date of last production \_\_\_\_\_ 19\_\_\_\_  
Was permission obtained from the Conservation Division or its agents before plugging was commenced? Yes

Name of Conservation Agent who supervised plugging of this well S. S. Greidel, Wichita  
Producing formation \_\_\_\_\_ Depth to top \_\_\_\_\_ Bottom \_\_\_\_\_ Total Depth of Well 3770 Feet  
Show depth and thickness of all water, oil and gas formations.

OIL, GAS OR WATER RECORDS

CASING RECORD

FORMATION	CONTENT	FROM	TO	SIZE	PUT IN	PULLED OUT
		0	252	8 5/8"	252	none

Describe in detail the manner in which the well was plugged, indicating where the mud fluid was placed and the method or methods used in introducing it into the hole. If cement or other plugs were used, state the character of same and depth placed, from \_\_\_\_\_ feet to \_\_\_\_\_ feet for each plug set.

From 3770' to 250' - heavy rotary mud and plug  
250' to 204' - 15 sacks cement  
204' to 30' - heavy rotary mud and plug  
30' to 6' - 10 sacks cement  
6' to surface - cellar

1-30-58

(If additional description is necessary, use BACK of this sheet)  
Name of Plugging Contractor Glenn W. Peel  
Address P.O. Box 359, Hoisington, Kansas

STATE OF KANSAS, COUNTY OF BARTON, ss.  
Glenn W. Peel (employee of owner) or (~~owner or operator~~) of the above-described well, being first duly sworn on oath, says: That I have knowledge of the facts, statements, and matters herein contained and the log of the above-described well as filed and that the same are true and correct. So help me God. GLENN W. PEEL

(Signature) By: Al H. Smith  
P.O. Box 359, Hoisington, Kansas  
(Address)

SUBSCRIBED AND SWORN TO before me this 2nd day of August, 19 57

Ruth Brant  
Notary Public.

My commission expires April 27, 1960

PLUGGING  
11 SEC 17 T. 22 R. 12 W  
BOOK PAGE 31 LI E 18

DRILLERS' LOG

Company: R. W. Shields

C NE NE SW  
Sec. 17, Twp. 22S, Rge. 12W,

Farm Name: Teichmann Well No. 1

County: Stafford,  
Kansas

Total Depth: 3770'

Comm: 7/17/57 Comp: 7/26/57  
Contractor: Glenn W. Peel

Elevation:

Production: Dry

Casing: 8 5/8" @ 252' cem.

Figures below indicate bottoms of formations:

Sand and shells	0 -	125
Sand		210
Shale and shells		252
Shale and red bed		685
Anhydrite		715
Shale		995
Red bed, shale and shells		1580
Lime and chert		1760
Lime		2125
Lime and shale		2630
Shale and lime streaks		2835
Lime		3025
Sand streaks		3104
Lime and shale		3410
Lime		3565
Shale and cherty conglomerate		3598
Chert		3623
Shale and chert		3680
Lime and chert		3712
Lime		3770
Total Depth		3770

This is to certify that the above information is to the best of our knowledge, true and correct.

GLENN W. PEEL

BY: Al H. Smith

SUBSCRIBED AND SWORN to before me this 2nd day of August, 1957

My commission expires: April 27, 1960

Ruth Brant  
Notary Public

PLUGGING  
FILE SEC. 17 T. 22 R. 12W  
BOOK PAGE 31 LINE 18