

RECEIVED

15-185-20484-0000

MAR 12 1974

Form CP-4

STATE OF KANSAS
STATE CORPORATION COMMISSION

Give All Information Completely
Make Required Affidavit
Mail or Deliver Report to:
Conservation Division
State Corporation Commission


PETROLEUM, INC.
Geological Dept.

WELL PLUGGING RECORD

P. O. Box 17027
Wichita, Kansas 67217
NORTH

Stafford County, Sec. 22 Twp. 22S. Rge. (E) 12 (W)

Location as "NE/CNWxSWx" or footage from lines C N/2 NW NW
Lease Owner Petroleum, Inc.
Lease Name Ukens 'H' Well No. 1
Office Address R. H. Garvey Bldg. 300 W. Douglas
Character of Well (completed as Oil, Gas or Dry Hole) Dry Hole
Date well completed March 6 19 74
Application for plugging filed March 6 19 74
Application for plugging approved March 6 19 74
Plugging commenced March 6 19 74
Plugging completed March 6 19 74
Reason for abandonment of well or producing formation Dry Hole

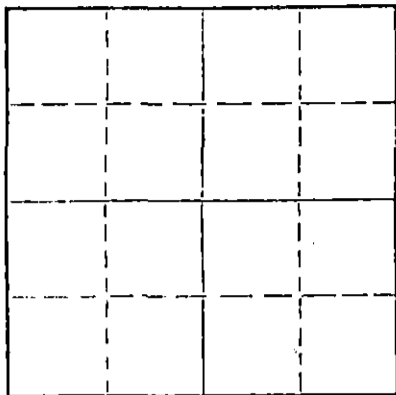

Locate well correctly on above Section Plat

If a producing well is abandoned, date of last production 19
Was permission obtained from the Conservation Division or its agents before plugging was commenced? Yes

Name of Conservation Agent who supervised plugging of this well G. R. Biberstein
Producing formation Depth to top Bottom Total Depth of Well 3681 Feet
Show depth and thickness of all water, oil and gas formations.

OIL, GAS OR WATER RECORDS

CASING RECORD

FORMATION	CONTENT	FROM	TO	SIZE	PUT IN	PULLED OUT
				8 5/8	289'	

Describe in detail the manner in which the well was plugged, indicating where the mud fluid was placed and the method or methods used in introducing it into the hole. If cement or other plugs were used, state the character of same and depth placed, from feet to feet for each plug set.

1st plug 500' w/40 sx.
2nd plug 250' w/30 sx.
3rd plug 40' w/15 sx.

RECEIVED
STATE CORPORATION COMMISSION
APR 10 1974
CONSERVATION DIVISION
Wichita, Kansas

4-10-74

Name of Plugging Contractor Woodman & Iannitti Drilling Co.
Address 1008 Union National Bldg.

STATE OF KANSAS, COUNTY OF SEDGWICK ss
K. T. WOODMAN (employee of owner) or (owner or operator) of the above-described well, being first duly sworn on oath, says: That I have knowledge of the facts, statements, and matters herein contained and the log of the above-described well as filed and that the same are true and correct. So help me God.

(Signature) K. T. Woodman
1008 Union Nat'l. Bldg.
(Address)

SUBSCRIBED AND SWORN TO before me this 7th day of March, 19 74

My commission expires Feb. 11, 1976
Justina Chamberlain Notary Public.

K. T. WOODMAN
RES. PHONE 733-0418
OFF. PHONE 265-7650
WICHITA, KANSAS

D. J. IANNITTI
PHONE 792-2921
GREAT BEND, KANSAS

WOODMAN & IANNITTI DRILLING COMPANY

Rotary Drilling Contractors

1008 UNION NATIONAL BUILDING
WICHITA, KANSAS 67202

March 7, 1974

Company;	Petroleum, Inc.
Farm;	Ukens 'H' #1
Location;	C N/2 NW NW
Section;	22-22S-12W
County;	Stafford
Contractor;;	Woodman & Iannitti Drilling Co.
Comm;	February 23, 1974
Compl;	March 6, 1974
Total Depth;	3681'
Casing;	8 5/8" @ 289 with 240 sx.
Production;	D & A

Figures Indicate Bottom Or Formations:

250	Shale & Sand
289	Red Bed
405	Shale
625	Red Bed
650	Anhy
725	Shale
1460	Shale
1680	Shale & Lime
2035	Lime
2175	Lime & Shale
2940	Shale & Lime
3085	Lime & Shale
3210	Lime
3320	Lime
3350	Lime
3363	Lime
3386	Lime
3400	Lime
3505	Lime
3526	Lime
3540	Lime
3605	Lime
3650	Lime
3681	Lime

RECEIVED
STATE CORPORATION COMMISSION
APR 10 1974
CONSERVATION DIVISION
Wichita, Kansas

Woodman & Iannitti Drilling Co.
K. T. Woodman
K. T. Woodman