


RP

WELL PLUGGING RECORD

Give All Information Completely
Make Required Affidavit
Mail or Deliver Report to:
Conservation Division
State Corporation Commission
212 North Market, Insurance Bldg.
Wichita, Kansas

NORTH

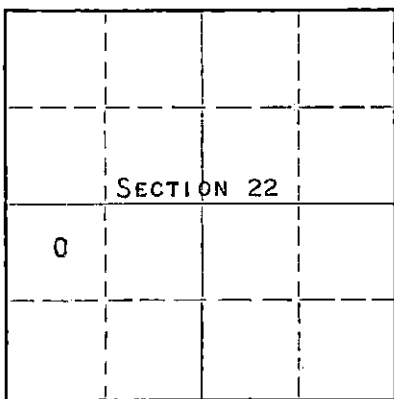

Locate well correctly on above Section Plat

STAFFORD County, Sec. 22 Twp. 22s Rge. 12 (#) (W)
Location as "NE/CNW%SW%" or footage from lines NW SW NW
Lease Owner PETROLEUM, INC.
Lease Name UKENS "E" Well No. 1
Office Address ROUTE 2, GREAT BEND, KANSAS
Character of Well (completed as Oil, Gas or Dry Hole) DRY HOLE
Date well completed APRIL 1 1960
Application for plugging filed APRIL 1 1960
Application for plugging approved APRIL 1 1960
Plugging commenced APRIL 1 1960
Plugging completed APRIL 1 1960
Reason for abandonment of well or producing formation
NO PRODUCIBLE ZONES
If a producing well is abandoned, date of last production NONE 19
Was permission obtained from the Conservation Division or its agents before plugging was commenced? YES

Name of Conservation Agent who supervised plugging of this well FRANK BROADFOOT, ST. JOHN, KANSAS
Producing formation _____ Depth to top _____ Bottom _____ Total Depth of Well 3719 Feet
Show depth and thickness of all water, oil and gas formations.

OIL, GAS OR WATER RECORDS

CASING RECORD

FORMATION	CONTENT	FROM	TO	SIZE	PUT IN	PULLED OUT
				8-5/8"	289'	NONE

Describe in detail the manner in which the well was plugged, indicating where the mud fluid was placed and the method or methods used in introducing it into the hole. If cement or other plugs were used, state the character of same and depth placed, from _____ feet to _____ feet for each plug set.

MUD UP WITH HEAVY MUD TO 240'. PUSHED DOWN A WOODEN PLUG FOLLOWED BY 1/4 SACK HULLS, PLACED 20 SACKS CEMENT THROUGH DRILL PIPE ON TOP OF HULLS. MUD UP WITH HEAVY MUD TO 35' FOLLOWED BY WOODEN PLUG, 1/4 SACK HULLS AND 10 SACKS CEMENT TO BASE OF WELL CELLAR.

RECEIVED
STATE CORPORATION COMMISSION

APR 22 1960

CONSERVATION DIVISION
Wichita, Kansas

4-22-60

(If additional description is necessary, use BACK of this sheet)
Name of Plugging Contractor GARVEY DRILLING COMPANY
Address ROUTE 2, GREAT BEND, KANSAS

STATE OF KANSAS, COUNTY OF BARTON, ss.
DON SEARLE (employee of owner) or (owner or operator) of the above-described well, being first duly sworn on oath, says: That I have knowledge of the facts, statements, and matters herein contained and the log of the above-described well as filed and that the same are true and correct. So help me God.

(Signature) *Don Searle*
ROUTE 2, GREAT BEND, KANSAS
(Address)

SUBSCRIBED AND SWORN TO before me this 19TH day of APRIL, 1960

My commission expires APRIL 14, 1963 *Arthur J. Mule* Notary Public.



WELL LOG

COMPANY PETROLEUM, INCORPORATED

SEC. 22 T.22S R. 12W

FARM UKENS "E" NO. 1


LOC. NW, SW, NW

TOTAL DEPTH 3719'

COUNTY STAFFORD CO., KANSAS

COMM. March 21, 1960 m COMP. April 1, 1960

CONTRACTOR GARVEY DRILLING COMPANY

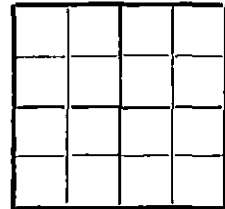

CASING 8 5/8" @ 289' w/225 sax.

ELEVATION 1873' DF

PRODUCTION D & A

FIGURES INDICATE BOTTOM OF FORMATIONS

100	Sand & surface soil
170	Sand
289	Red bed
655	Red bed & shale
680	Anhydrite
1240	Shale & shells
1560	Shale
2070	Lime
2255	Lime & shale
2470	Shale & lime
2625	Lime & shale
2825	Shale & lime
2969	Lime & shale
3197	Lime
3293	Douglas shale
3316	Lime & shale
3625	Lime
3638	Lime & chert
3648	Shale
3680	Lime
3694	Simpson shale
3719	Arbuckle
3719	T. D.

RECEIVED
STATE CORPORATION COMMISSION
APR 22 1960
CONSERVATION DIVISION
Wichita, Kansas

State of KANSAS }
County of BARTON } ss:

I, VERNE A. MORRIS of GARVEY DRILLING COMPANY

upon oath state that the above and foregoing is a true and correct copy of the log of the #1 UKENS "E" well.

Verne A. Morris

Subscribed and sworn to before me this 18th day of April 19 60

My Commission Expires: April 14, 1963

Arthur J. Gales
NOTARY PUBLIC