


STATE OF KANSAS
STATE CORPORATION COMMISSION

WELL PLUGGING RECORD

Give All Information Completely
Make Required Affidavit
Mail or Deliver Report to:
Conservation Division
State Corporation Commission
800 Bitting Building
Wichita, Kansas

Stafford County, Sec. 22 Twp. 22 Rge. 12 (W)
Location as "NE/CNW $\frac{1}{4}$ /SW $\frac{1}{4}$ " or footage from lines SE SE NW
Lease Owner The Derby Oil Company
Lease Name Fruehauf Well No. 1
Office Address 420 West Douglas, Wichita, Kansas
Character of Well (completed as Oil, Gas or Dry Hole) Dry Hole
Date well completed September 1, 19 51
Application for plugging filed September 1, 19 51
Application for plugging approved September 5, 19 51
Plugging commenced September 2, 19 51
Plugging completed September 2, 19 51
Reason for abandonment of well or producing formation Dry Hole

NORTH

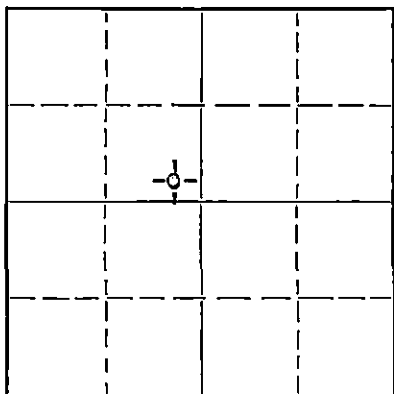

Locate well correctly on above
Section Plat

If a producing well is abandoned, date of last production 19
Was permission obtained from the Conservation Division or its agents before plugging was com-
menced? Yes

Name of Conservation Agent who supervised plugging of this well C. D. Stough
Producing formation --- Depth to top --- Bottom --- Total Depth of Well 3696 Feet
Show depth and thickness of all water, oil and gas formations.

OIL, GAS OR WATER RECORDS

CASING RECORD

Formation	Content	From	To	Size	Put In	Pulled Out
				8 5/8"	255	None

Describe in detail the manner in which the well was plugged, indicating where the mud fluid was placed and the method or methods used in introducing it into the hole. If cement or other plugs were used, state the character of same and depth placed, from --- feet to --- feet for each plug set.

From 3696' to 251 $\frac{1}{2}$ ' - Heavy Rotary mud
From 251 $\frac{1}{2}$ ' to 250' - Wooden Plug
From 250' to 204' - Fifteen sacks of cement
From 204' to 36 $\frac{1}{2}$ ' - Heavy Rotary mud
From 36 $\frac{1}{2}$ ' to 35' - Wooden plug
From 35' to 6' - Ten sacks of cement
From 6' to Surface cellar

9-21-51

STATE CORPORATION COMMISSION
SEP 21 1951
CONSERVATION DIVISION
Wichita, Kansas

Name of Plugging Contractor Peel Brothers Drilling Company
Address Hoisington, Kansas

STATE OF Kansas, COUNTY OF Sedgwick, ss.
F. W. Heiser (employee of owner) or (owner/contractor) of the above-described well,
being first duly sworn on oath, says: That I have knowledge of the facts, statements, and matters herein contained and the log of the above-described well as filed and that the same are true and correct. So help me God

(Signature) F. W. Heiser
F. W. Heiser, Exploitation Engineer
Box 1030, Wichita, Kansas (Address)

SUBSCRIBED AND SWORN TO before me this 12th day of September, 19 51

H. A. Bilson, Notary Public.

My commission expires August 21, 1953.

PLUGGING
FILE SEC. 22 T. 22 R. 12
BOOK PAGE 107 (REV. 32)

-----DRILLER'S LOG-----

Company: Derby Oil Company
 Farm: Fruehauf # 1
 Total Depth: 3969'
 Contractor: Peel Bros. Inc.

Elevation:
 Production:

Figures below indicate bottom formations:

Sand and Soil	0'	160'
Shale and Shells		255
Shale and Red Bed		775
Anhydrite		820
Shale		1130
Shale and Salt		1240
Shale		1300
Shale and Shells		1600
Lime and Shale		1745
Lime		1835
Lime and Shale		2215
Shale and Shells		2570
Shale		2790
Shale and Shells		2875
Lime andn Shale		3320
Lime		3600
Lime and Cherty		3630
Lime		3695
Dolomite		3696
Total Depth		3696

Mendell E. Peel

Subscribed and Sworn to before me this 7th day of September, 1951

My Commission expires June 9, 1951

Marian M. Herbert
 Notary Public

SEP 21 1951

