


WELL PLUGGING RECORD

Give All Information Completely
Make Required Affidavit
Mail or Deliver Report to
Conservation Division
State Corporation Commission
800 Bittig Building
Wichita, Kansas

Stafford County, Sec. 22 Twp. 22 Rge. (E) 12 (W)

Location as "NE/CNW%SW%" or footage from lines SW NE NE
Lease Owner Musgrove Petroleum Corporation
Lease Name SMITH Well No. #2
Office Address 518 Petroleum Building, Wichita, Kansas.
Character of Well (completed as Oil, Gas or Dry Hole) Dry
Date well completed July 5, 1952
Application for plugging filed November 18, 1954
Application for plugging approved November 19, 1954
Plugging commenced December 9, 1954
Plugging completed December 9, 1954
Reason for abandonment of well or producing formation Dry

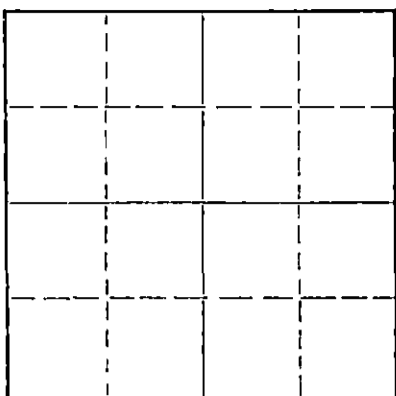

Locate well correctly on above Section Plat

If a producing well is abandoned, date of last production October 19 54
Was permission obtained from the Conservation Division or its agents before plugging was commenced?

Name of Conservation Agent who supervised plugging of this well Warren H. Horner
Producing formation _____ Depth to top _____ Bottom _____ Total Depth of Well 3691 Feet
Show depth and thickness of all water, oil and gas formations.

OIL, GAS OR WATER RECORDS

CASING RECORD

FORMATION	CONTENT	FROM	TO	SIZE	PUT IN	PULLED OUT
				8-5/8"	222	
				5-1/2"	3686'	2753' 5-1/2"

Describe in detail the manner in which the well was plugged, indicating where the mud fluid was placed and the method or methods used in introducing it into the hole. If cement or other plugs were used, state the character of same and depth placed, from _____ feet to _____ feet for each plug set.

Filled hole with sand to 3670'.
Set first plug at 3630 with 5 sx cement.
Filled hole with mud to 250'.
Set rock bridge to 240'.
Set second plug at 240' with 20 sx cement.
Filled hole with mud to 35'.
Set 5' rock bridge to 30' with 10 sx cement.
Filled to base of cellar.

(If additional description is necessary, use BACK of this sheet)

Name of Plugging Contractor Jayhawk Casing Pulling Company,
Address Russell, Kansas.

STATE OF Kansas, COUNTY OF Sedgwick ss.
Gordon L. Koelling (employee of owner) or (owner or operator) of the above-described well, being first duly sworn on oath, says: That I have knowledge of the facts, statements, and matters herein contained and the log of the above-described well as filed and that the same are true and correct. So help me God.

(Signature) Gordon L. Koelling
518 Petroleum Building, Wichita, Kansas.
(Address)

SUBSCRIBED AND SWORN to before me this 23rd day of December, 19 54

My commission expires July 16, 1955

Alma E. Lusa
Notary Public.

PLUGGING
FILE SEC 22 T 22 R 12W
BOOK PAGE 28 LINE 36

12-24-54

CONTRACTOR'S WELL LOG

COMPANY: Musgrove Petroleum Corporation
 CONTRACTOR: Musgrove Petroleum Corporation
 FARM: Smith #2
 LOCATION: SW NE NE Section 22-22S-12W
 Stafford County, Kansas
 COMMENCED: June 24, 1952
 COMPLETED: July 5, 1952

0	175	Surface clay & sand
175	400	Redbed
400	700	Shale & redbed
700	1010	Blue shale
1010	1080	Anhydrite
1080	1440	Shale
1440	1575	Lime & shale
1575	1770	Lime
1770	2410	Lime & shale
2410	2725	Shale
2725	3236	Shale & lime
3236	3292	Shale
3292	3404	Lime & shale
3404	3606	Lime
3606	3650	Lime & shale
3650	3691	Lime
	3691	Rotary Total Depth

Set 222' of 8-5/8" surface casing, cemented with 175 sacks.

Set 5-1/2" casing at 3686', cemented with 100 sacks.

STATE OF KANSAS)
) SS:
 COUNTY OF SEDGWICK)

I, GORDON L. KOELLING, do hereby certify that the above and foregoing is a true and correct copy of the log of Smith #2, Section 22-22S-12W, Stafford County, Kansas, as reflected by the files of the Musgrove Petroleum Corporation.

MUSGROVE PETROLEUM CORPORATION

By: Gordon L. Koelling
 Secretary-Treasurer

Subscribed and sworn to before me, a Notary Public, within and for Sedgwick County, Kansas, this 16th day of July, 1952.

Ada C. May
 Notary Public

My commission expires August 31, 1955.

PLUGGING
 FILE NO. 22-22S-12W
 BOOK PAGE 78 LINE 36