


STATE OF KANSAS
STATE CORPORATION COMMISSION

WELL PLUGGING RECORD

Give All Information Completely
Make Required Affidavit
Mail or Deliver Report to
Conservation Division
State Corporation Comm.
245 North Water
Wichita, KS 67202

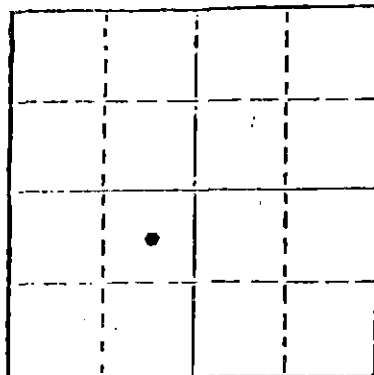

Locate well correctly on above
Section Plot

Hamilton County, Sec. 21 Twp. 22 Rge. 39 NE/4
Location as "NE/CNW 1/4 SW 1/4" or footage from lines
C- NE-SW

Lease Owner Woolsey Petroleum Corp.
Lease Name Fritzemeier Well No. 1
Office Address 300 W. Douglas, Wichita, Ks. 67202
Character of Well (Completed as Oil, Gas or Dry Hole)
Gas

Date Well completed 4-29-81 19
Application for plugging filed 6-29-81 19
Application for plugging approved 7-13-81 19
Plugging commenced 9-1-81 19
Plugging completed 9-2-81 19

Reason for abandonment of well or producing formation
Non Commercial Value

If a producing well is abandoned, date of last production
None 19

Was permission obtained from the Conservation Division or
its agents before plugging was commenced? yes

Name of Conservation Agent who supervised plugging of this well Mr. Thomas
Producing formation Depth to top 2760' Bottom 2770' Total Depth of Well 3000'
Show depth and thickness of all water, oil and gas formations.

OIL, GAS OR WATER RECORDS

CASING RECORD

FORMATION	CONTENT	FROM	TO	SIZE	PUT IN	PULLED OUT
Surface				8 5/8"	842'	0'
Production				4 1/2"	2999'	2270'

Describe in detail the manner in which the well was plugged, indicating where the mud fluid
was placed and the method or methods used in introducing it into the hold. If cement or other
plugs were used, state the character of same and depth placed, from feet to
feet for each plug set.

Pumped 1 sk. hulls & 15 sks. cement to 2530' Pressured to 750 lbs.

Displaced to 1030' 27 mud

Pumped 60 sks. cement 1030' to 830'

Layed down rest of 4 1/2" casing

Pushed plug to 750' & pumped 35 sks. cement 750' to 650'

Put bridge & 10 sks. cement 40' to 0'

Cut off 8 5/8", 3' below ground level

RECEIVED
STATE CORPORATION COMMISSION

OCT 26 1981

CONSERVATION DIVISION
Wichita, Kansas

(If additional description is necessary, use BACK of this sheet)

Name of Plugging Contractor Midwest Casing Pulling Service
Permit # 766

10-26-81

STATE OF KANSAS

COUNTY OF HASKELL

ss.

I, Edgar J. Eves

(Employee of Owner) or (owner or operator)

of the above-described well, being first duly sworn on oath, says: That I have knowledge of
the facts, statements, and matters herein contained and the log of the above-described well
as filed and that the same are true and correct. So help me God.

(Signature)

Box F, Gablette, Ks. 67877

(Address)

SUBSCRIBED AND SWORN TO before me this 9th day of Sept., 1981

Sondra L. Eves

Notary Public.

My commission expires 12-6-84



KANSAS DRILLER'S LOG

LEASE: FRITZEMEIER #1-21
 OWNER: WOOLSEY PETROLEUM CORPORATION
 SPUD: 2-12-81
 COMP: 2-17-81

LOCATION: C NE SW
 SECTION 21-22S-39W
 HAMILTON COUNTY, KANSAS
 CASING: 8 5/8" Set @ 842'
 5 1/2" Set @ 2999'

Soils & Sand	843
Sand & Red Bed	2015
Shale & Anhydrite	2525
Shale	2735
Shale & Lime	2790
Shale	2830
Lime & Shale	2970
Lime	3000
R.T.D.	3000

RECEIVED
 STATE CORPORATION COMMISSION
 OCT 26 1981
 CONSERVATION DIVISION
 Wichita, Kansas

STATE OF KANSAS)
)
 COUNTY OF SEDGWICK) ss.

I, William C. Wakefield, do hereby certify that this is a true and correct Driller's Log on the FRITZEMEIER #1-21, located C NE SW SECTION 21-22S-39W, HAMILTON COUNTY, KANSAS, as shown by the daily drilling reports.


EARL F. WAKEFIELD, INC.

By William C. Wakefield
 William C. Wakefield

Subscribed and Sworn to before me this 25th Day of February, 1981.

My Appointment Expires:
October 28, 1984

Carol J. Noel
 Carol J. Noel Notary Public

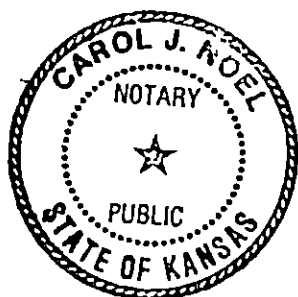

KANSAS

IMPORTANT
Kans. Geo. Survey request
samples on this well.

WELL COMPLETION REPORT AND
DRILLER'S LOG
 API No. 15 — 075 — 20,365-0000
 County Number

Operator

Woolsey Petroleum Corp.

Address

300 West Douglas, Suite 400 Wichita, Kansas 67202

Well No.

#1

Lease Name

Fritzenieier

Footage Location

feet from (N) (S) line

feet from (E) (W) line

Principal Contractor

Earl F. Wakefield, Inc.

Geologist

N/A

Spud Date

2/12/81

Date Completed

4/29/81

Total Depth

3000'

P.B.T.D.

2950'

Directional Deviation

Oil and/or Gas Purchaser


S. 21 T. 22 R. 39 ²W

Loc. C NE SW

County Hamilton

640 Acres

N

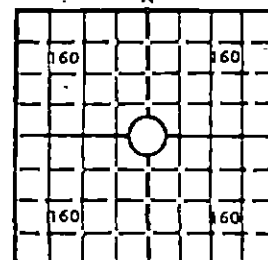

Locate well correctly

Elev.: Gr.

3472

STATE CORPORATION COMMISSION

DF

KB

3480'

OCT 26 1981

CASING RECORD

Report of all strings set — surface, intermediate, production, etc.

CONSERVATION DIVISION

Wichita, Kansas

Purpose of string	Size hole drilled	Size casing set (in O.D.)	Weight lbs/ft.	Setting depth	Type cement	Sacks	Type and percent additives
Surface	12 1/2"	8 5/8"	24#	842'	Class H HLC	150 300	3%cc 2%cc
Production	7 7/8"	4 1/2"	10.5#	2999'	Class H	125	18% salt 3/4% CFR-2

LINER RECORD

PERFORATION RECORD

Top, ft.	Bottom, ft.	Sacks cement	Shots per ft.	Size & type	Depth interval
			2	1/2" jets	2760-2770
TUBING RECORD					
Size	Setting depth	Packer set at			

ACID, FRACTURE, SHOT, CEMENT SQUEEZE RECORD

Amount and kind of material used	Depth interval treated
11550 gal Versagel, 40 tons CO2, 12000# 20-40 sd, 20000#	
10-20 sd.	2760-2770'

INITIAL PRODUCTION

Date of first production		Producing method (flowing, pumping, gas lift, etc.)			
RATE OF PRODUCTION PER 24 HOURS		Oil bbls.	Gas MCF	Water bbls.	Gas-oil ratio CFPB
Disposition of gas (vented, used on lease or sold)				Producing interval(s)	

INSTRUCTIONS: As provided in KCC Rule 82-2-125, within 90 days after completion of a well, one completed copy of this Drillers Log shall be transmitted to the State Geological Survey of Kansas, 4150 Monroe Street, Wichita, Kansas 67209. Copies of this form are available from the Conservation Division, State Corporation Commission, 245 No. Water, Wichita, Kansas 67202. Phone AC 316-522-2206. If confidential custody is desired, please note Rule 82-2-125. Drillers Logs will be on open file in the Oil and Gas Division, State Geological Survey of Kansas, Lawrence, Kansas 66044.

15-075-20365-0000

DESIGNATE TYPE OF COMP.: OIL, GAS,
DRY HOLE, SWDW, ETC.:

Dry Hole

Operator

Woolsey Petroleum Corporation

Well No.

1-21

Lease Name

Fritzemeier

S 21 T 22 R 39

C NE SW

WELL LOG

Show all important zones of porosity and contents thereof; cored intervals, and all drill-stem tests, including depth interval tested, cushion used, time tool open, flowing and shut-in pressures, and recoveries.

SHOW GEOLOGICAL MARKERS, LOGS RUN,
OR OTHER DESCRIPTIVE INFORMATION.

FORMATION DESCRIPTION, CONTENTS, ETC.

TOP

BOTTOM

NAME

DEPTH

DST #1 2750-2790' (Winfield)

30-60-60-120

1st Op: WB inc. FB

2nd Op: FB

Rec: 30' DM

IHP 1481# FFP 54-57#

IFP 43-57# FSIP 308#

ISIP 246# FHP 1481#

DST #2 2790-2830' (Towanda)

30-60-60-120

1st Op: WB to FB

2nd Op: FB

Rec: 75' DM

IHP 1511# FFP 58-101#

IFP 43-72# FSIP 346#

ISIP 245# FHP 1511#

BHT 89°F

USE ADDITIONAL SHEETS, IF NECESSARY, TO COMPLETE WELL RECORD.

Date Received

Signature

Ronald J. Miller, Operations Manager

Title

June 29, 1981

Date