

STATE OF KANSAS
STATE CORPORATION COMMISSION

WELL PLUGGING RECORD


Give All Information Completely
Make Required Affidavit
Mail, or Deliver Report to:
Conservation Division
State Corporation Commission
800 Bitting Building
Wichita, Kansas

OR

FORMATION PLUGGING RECORD

Strike out upper line
when reporting plug-
ging off formations.

Stafford County. Sec. 21 Twp. 22 Rge. 12 (E) West (W)
Location as "NE $\frac{1}{4}$ NW $\frac{1}{4}$ SW $\frac{1}{4}$ " or footage from lines. NW NW NW
Lease Owner. Hilton Drilling Company, Inc.
Lease Name. Spangenberg Well No. 1
Office Address. 2421 Tenth Street, Great Bend, Kansas
Character of Well (completed as Oil, Gas or Dry Hole) Dry Hole
Date well completed. August 7 19 52
Application for plugging filed. August 7 19 52
Application for plugging approved. August 7 19 52
Plugging commenced. August 7 19 52
Plugging completed. August 7 19 52
Reason for abandonment of well or producing formation. Dry Hole

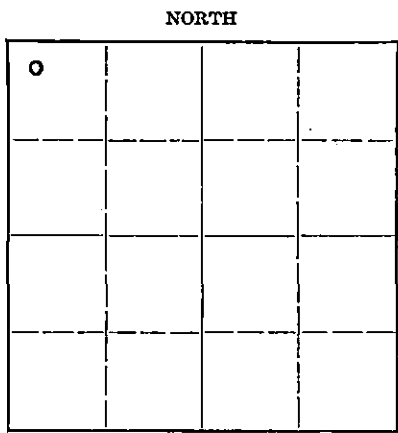

Locate well correctly on above
Section Plat

If a producing well is abandoned, date of last production.....19.....
Was permission obtained from the Conservation Division or its agents before plugging was com-
menced?.....yes

Name of Conservation Agent who supervised plugging of this well.....~~XXXXXXXXXX~~ Rives
Producing formation..... Depth to top..... Bottom..... Total Depth of Well. 3712 Feet
Show depth and thickness of all water, oil and gas formations.

OIL, GAS OR WATER RECORDS

CASING RECORD

Formation	Content	From	To	Size	Put In	Pulled Out
				8 5/8	225	none

Describe in detail the manner in which the well was plugged, indicating where the mud fluid was placed and the method or methods used in introducing it into the hold. If cement or other plugs were used, state the character of same and depth placed, from.....feet to.....feet for each plug set.

Hole was filled with heavy rotary mud from bottom to 210 ft.
Plug down at 210 ft. and 20 sacks cement on top of plug then
filled with heavy rotary mud to 35 ft. with 10 sacks cement from
top plug to surface.

(If additional description is necessary, use BACK of this sheet)

Correspondence regarding this well should be addressed to Hilton Drilling Company, Inc.
Address P. O. Box 164, Great Bend, Kansas

STATE OF Kansas, COUNTY OF Barton, ss.

Henry Peacock, Secretary (employee of owner) or (owner or operator) of the above-described well,
being first duly sworn on oath, says: That I have knowledge of the facts, statements, and matters herein contained and the log of the above-
described well as filed and that the same are true and correct. So help me God.

(Signature) Henry Peacock Secretary

2421 Tenth Street, Great Bend, Kansas
(Address)

SUBSCRIBED AND SWORN to before me this 9th day of August, 19 52

My commission expires April 4, 1956

Margaret Whitmore
Notary Public.

21-6858-RS 2-47-6M
FILE SEC 21 T 22 R 24
BOOK PAGE 36 LINE 49

AUG 11 1952 8-11-52

CONSERVATION DIVISION
Wichita, Kansas

