


WELL PLUGGING RECORD

Give All Information Completely
Make Required Affidavit
Mail or Deliver Report to:
Conservation Division
State Corporation Commission
800 Bittling Building
Wichita, Kansas

NORTH

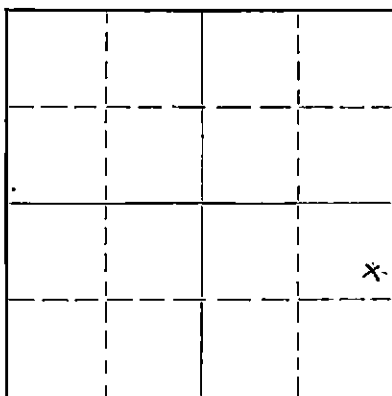

Locate well correctly on above
Section Plat

Stafford County, Sec. 21 Twp. 22 Rge. (E) 12 (W)
Location as "NE/CNW $\frac{1}{4}$ /SW $\frac{1}{4}$ " or footage from lines SE NE SE
Lease Owner Chas. H. Brown
Lease Name Spangenberg Well No. 2
Office Address P.O. Box 36 Great Bend, Kansas
Character of Well (completed as Oil, Gas or Dry Hole) Dry Hole
Date well completed June 7 19 53
Application for plugging filed June 23 19 53
Application for plugging approved June 24 19 53
Plugging commenced June 30 19 53
Plugging completed July 2 19 53
Reason for abandonment of well or producing formation Dry Hole

If a producing well is abandoned, date of last production 19...
Was permission obtained from the Conservation Division or its agents before plugging was commenced? Yes

Name of Conservation Agent who supervised plugging of this well Mr. M. A. Rives
Producing formation Depth to top Bottom Total Depth of Well 3712 Feet
Show depth and thickness of all water, oil and gas formations.

OIL, GAS OR WATER RECORDS

CASING RECORD

Formation	Content	From	To	Size	Put In	Pulled Out
Arbuckle				5 $\frac{1}{2}$	3709 Ft.	3030 Ft.

Describe in detail the manner in which the well was plugged, indicating where the mud fluid was placed and the method or methods used in introducing it into the hole. If cement or other plugs were used, state the character of same and depth placed, from... feet to... feet for each plug set.

Filled to 3700 feet with chat; ran 5 sacks cement; mudded to 250 feet; set rock bridge; ran 20 sacks cement; mudded to 35 feet; set rock bridge; ran 10 sacks cement.

(If additional description is necessary, use BACK of this sheet)

Correspondence regarding this well should be addressed to Chas. Hulme Drilling Contractor
Address P.O. Box 36 Great Bend, Kansas

STATE OF Kansas, COUNTY OF Barton, ss.
C. E. Byars (employee of owner) or (owner or operator) of the above-described well,
being first duly sworn on oath, says: That I have knowledge of the facts, statements, and matters herein contained and the log of the above-described well as filed and that the same are true and correct. So help me God.

(Signature) *C. E. Byars*
Great Bend, Kansas
(Address)

SUBSCRIBED AND SWORN to before me this 9th day of July, 19 53.
Steph. J. Johnson Notary Public.

My commission expires October 15, 1953

22-7877-5 4-19-10M
PLUGGING
FILE SEC. 21 T. 22 R. 12 W
BOOK PAGE 110 LINE 6

RECEIVED
STATE CORPORATION COMMISSION
JUL 10 1953
7-10-53
CONSERVATION DIVISION
Wichita, Kansas

SPANGENBERG #2
E/2 SE/4 21-22-12, Stafford County, Kansas

Lease Owner: Chas. H. Brown, St. Louis, Missouri

Lease Operator: Chas. Hulme Drilling Contractor, Great Bend, Kansas

Date Begun: May 26, 1953

Date Completed: June 7, 1953

Surface Pipe: 249 Ft. 8 5/8" with 175 sacks cement

Oil String: 3709 Ft. 5 1/2" O.D. casing

DRILLERS LOG

Sand and Red Bed	0	250 Feet
Red Bed and Shale	250	840
Shale	840	1440
Salt	1440	1490
Shale and Shells	1490	1590
Shale and Lime	1590	1720
Lime	1720	1800
Shale	1800	1850
Lime	1850	2020
Shale	2020	2145
Shale and Shells	2145	2285
Shale	2285	2665
Shale and Lime	2665	2750
Broken Lime	2750	2895
Lime	2895	3180
Lime and Shale	3180	3280
Shale and Lime	3280	3345
Lime	3345	3712
TD	3712	

