


Give All Information Completely  
Make Required Affidavit  
Mail or Deliver Report to:  
Conservation Division  
State Corporation Commission  
212 North Market, Insurance Bldg.  
Wichita, Kansas

WELL PLUGGING RECORD

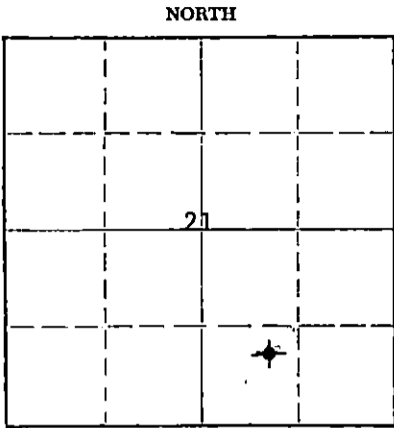

Locate well correctly on above Section Plat

Stafford County, Sec. 21 Twp 22 Rge. 12 (E) W (W)  
Location as "NE/CNW/SW" or footage from lines NE SW SE  
Lease Owner Icer Addis  
Lease Name Spangenberg Well No. 1  
Office Address P. O. Box 519, Great Bend, Kansas  
Character of Well (completed as Oil, Gas or Dry Hole) Dry Hole  
Date well completed November 17 19 61  
Application for plugging filed November 22 19 61  
Application for plugging approved 19  
Plugging commenced 4 P.M. November 17 19 61  
Plugging completed 10 P.M. November 17 19 61  
Reason for abandonment of well or producing formation Dry & Abandoned

If a producing well is abandoned, date of last production 19  
Was permission obtained from the Conservation Division or its agents before plugging was commenced? Yes

Name of Conservation Agent who supervised plugging of this well W. L. Lac Kamp  
Producing formation Depth to top Bottom Total Depth of Well 3703 Feet  
Show depth and thickness of all water, oil and gas formations.

OIL, GAS OR WATER RECORDS

CASING RECORD

FORMATION	CONTENT	FROM	TO	SIZE	PUT IN	PULLED OUT
				8-5/8"	229'	none

Describe in detail the manner in which the well was plugged, indicating where the mud fluid was placed and the method or methods used in introducing it into the hole. If cement or other plugs were used, state the character of same and depth placed, from feet to feet for each plug set.

Bottom plug at 200', 20 sacks cement, 1/4 sacks hulls, Top plug @ 35'  
10 sacks cement, 1/2 sack hulls

RECEIVED  
STATE CORPORATION COMMISSION  
NOV 27 1961  
CONSERVATION DIVISION  
Wichita, Kansas

11-27-61

(If additional description is necessary, use BACK of this sheet)  
Name of Plugging Contractor Triangle Drilling, Inc.  
Address Box 519, Great Bend, Kansas

STATE OF KANSAS, COUNTY OF BARTON, ss.  
Donald D. Vaughan (employee of owner, contractor or operator) of the above-described well, being first duly sworn on oath, says: That I have knowledge of the facts, statements, and matters herein contained and the log of the above-described well as filed and that the same are true and correct. So help me God.

(Signature) Donald D. Vaughan  
Box 825, Great Bend, Kansas  
(Address)

SUBSCRIBED AND SWORN TO before me this 20th day of November, 1961

My commission expires July 1, 1964  
Jessie Lee Dunn, Notary Public.



WELL LOG

COMPANY Icer Addis  
 CONTRACTOR Triangle Drilling, Inc.  
 FARM #1 Spangenberg  
 LOCATION NE SW SE of Section 21-22-12W  
 Stafford County, Kansas  
 SURFACE PIPE 8-5/8" cemented @ 229' w/240 sacks HA-5 cement  
 PRODUCTION Dry & Abandoned  
 ELEVATION 1873 KB  
 COMMENCED 11-9-61  
 COMPLETED 11-17-61

<u>FORMATION</u>	<u>DEPTH</u>
Clay	35
Clay & Sand	180
Red Clay & shale	229
Redbed	655
Anhydrite	678
Shale & Shells	1400
Limestone & shale	2871
Limestone	3199
Shale	3298
Limestone	3592
Chert	3650
Shale	3696
Sand	3698
Dolomite	3703

FORMATION TOPS

Anhydrite	655	(+1218)	driller's
Topeka	2871	(- 998)	
Heebner	3166	(-1293)	
Toronto	3185	(-1312)	
Brown Limestone	3298	(-1425)	
Lansing	3318	(-1445)	
Viola	3592	(-1719)	
Simpson	3650	(-1777)	
Simpson Sand	3696	(-1823)	
Arbuckle	3698	(-1825)	
RTD	3703	(-1830)	


A F F I D A V I T

STATE OF KANSAS, COUNTY OF BARTON, SS.

I, Donald D. Vaughan, Petroleum Geologist, being first duly sworn on oath, state; That I have knowledge of the facts, statements and matters herein contained and that the same are true and correct.

  
 Donald D. Vaughan

Subscribed and sworn to before me this 20th day of November, 1961.

  
 Jessie Lee Dunn, Notary Public

My commission expires: July 1, 1964

RECEIVED  
 STATE CONSERVATION COMMISSION  
 NOV 27 1961  
 CONSERVATION DIVISION  
 Wichita, Kansas