


STATE OF KANSAS
STATE CORPORATION COMMISSION

WELL PLUGGING RECORD

Give All Information Completely
Make Required Affidavit
Mail or Deliver Report to
Conservation Division
State Corporation Comm.
245 North Water
Wichita, KS 67202

Stafford County. Sec. 9 Twp. 22 Rge. 14 NE
Location as "NE/CNW $\frac{1}{4}$ SW $\frac{1}{4}$ " or footage from lines _____

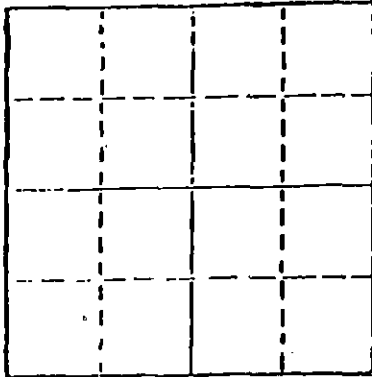

Locate well correctly on above
Section Plot

Lease Owner Sunburst Exploration Company
Lease Name Wycoff Well No. 1
Office Address 908 One Main Place, Wichita, Kansas 67202
Character of Well (Completed as Oil, Gas or Dry Hole) _____
Dry Hole

Date Well completed 8-7-81 19____
Application for plugging filed 8-7-81 19____
Application for plugging approved 8-7-81 19____
Plugging commenced 8-7-81 19____
Plugging completed 8-7-81 19____
Reason for abandonment of well or producing formation _____

If a producing well is abandoned, date of last production: _____ 19____

Was permission obtained from the Conservation Division of its agents before plugging was commenced? yes

Name of Conservation Agent who supervised plugging of this well Duane L. Rankin
Producing formation _____ Depth to top _____ Bottom _____ Total Depth of Well _____
Show depth and thickness of all water, oil and gas formations.

OIL, GAS OR WATER RECORDS

CASING RECORD

FORMATION	CONTENT	FROM	TO	SIZE	PUT IN	PULLED OUT

Describe in detail the manner in which the well was plugged, indicating where the mud fl was placed and the method or methods used in introducing it into the hold. If cement or ot plugs were used, state the character of same and depth placed, from _____ feet to _____ feet for each plug set.

1st Plug @ 660' w/60 sx
2nd Plug @ 390' w/40 sx
3rd Plug @ 40' w/10 sx
Rathole w/10sx

8-13-81

RECEIVED
STATE CORPORATION COMMISSION

AUG 15 1981

(If additional description is necessary, use BACK of this sheet)
Name of Plugging Contractor Sun Cement Wichita, Kansas

STATE OF Kansas COUNTY OF Sedgwick, ss.
K.T. Woodman, Partner (employee of owner) or (owner or opera
of the above-described well, being first duly sworn on oath, says: That I have knowledge o
the facts, statements, and matters herein contained and the log of the above-described well
as filed and that the same are true and correct. So help me God.

(Signature) K.T. Woodman
1008 Douglas Building, Wichita, Kansas 67
(Address)

SUBSCRIBED AND SWORN TO before me this 12th day of August, 19____

My commission expires 9-4-83

Kathy Ann Stewart
Notary Public.

KANSAS DRILLERS LOG

API No. 15 — Stafford — 185-21,354
 County Number

S. 9 T. 22 R. 14 ^{KCCX} W

Loc. NE SE SW

Operator


Sunburst Exploration Company

County Stafford

640 Acres
N

Address

708 One Main Place, Wichita, Kansas 67202

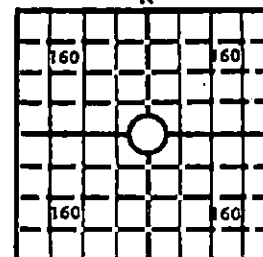

Locate well correctly

Well No.

#1

Lease Name

Wycoff

Footage Location

feet from (N) (S) line

feet from (E) (W) line

Principal Contractor

Woodman & Tannitti

Geologist

Spud Date

7-30-81

Total Depth

3876

P.B.T.D.

Date Completed

8-7-81

Oil Purchaser

Elev.: Gr. _____

DF _____ KB _____

CASING RECORD

Report of all strings set— surface, intermediate, production, etc.

Purpose of string	Size hole drilled	Size casing set (in O.D.)	Weight lbs/ft.	Setting depth	Type cement	Sacks	Type and percent additives
Surface	12-1/4	8-5/8	23	422	Common	275	

LINER RECORD

PERFORATION RECORD

Top, ft.	Bottom, ft.	Sacks cement	Shots per ft.	Size & type	Depth interval

TUBING RECORD

Size	Setting depth	Packer set at

ACID, FRACTURE, SHOT, CEMENT SQUEEZE RECORD

Amount and kind of material used	Depth interval treated

INITIAL PRODUCTION

Date of first production	Producing method (flowing, pumping, gas lift, etc.)			
RATE OF PRODUCTION PER 24 HOURS	Oil	Gas	Water	Gas:oil ratio
	bbbl.	MCF		
Disposition of gas (vented, used on lease or sold)			Producing interval (s)	

RECEIVED
STATE CORPORATION COMMISSION

AUG 13 1981

CONSERVATION DIVISION
Wichita, Kansas

CFPB

INSTRUCTIONS: As provided in KCC Rule 82-2-125, within 90 days after completion of a well, one completed copy of this Drillers Log shall be transmitted to the State Geological Survey of Kansas, 4150 Monroe Street, Wichita, Kansas 67209. Copies of this form are available from the Conservation Division, State Corporation Commission, 3830 So. Meridian (P.O. Box 17027), Wichita, Kansas 66217. Phone AC 316-522-2206. If confidential custody is desired, please note Rule 82-2-125. Drillers Logs will be an open file in the Oil and Gas Division, State Geological Survey of Kansas, Lawrence, Kansas 66044.

Operator Sunburst Exploration		DESIGNATE TYPE OF COMP.: OIL, GAS, DRY HOLE, SWDW, ETC.: Dry Hole
Well No. #1	Lease Name Wycoff	
S <u>9</u> T <u>22</u> R <u>14</u> EX W		

WELL LOG

Show all important zones of porosity and contents thereof; cored intervals, and all drill-stem tests, including depth interval tested, cushion used, time tool open, flowing and shut-in pressures, and recoveries.

SHOW GEOLOGICAL MARKERS, LOGS RUN, OR OTHER DESCRIPTIVE INFORMATION.

FORMATION DESCRIPTION, CONTENTS, ETC.	TOP	BOTTOM	NAME	DEPTH
Sand & Clay	0	422		
Sand	422	856		
Anhy	856	876		
Red Bed & Shale	1122	1784		
Lime & Shale	1784	1964		
Shale	1964	2150		
Lime & Shale	2150	2390		
Lime & Shale	2390	2556		
Shale & Lime	2556	2741		
Lime & Shale	2741	2914		
Lime & Shale	2914	3065		
Lime & Shale	3065	3178		
Lime & Shale	3178	3320		
Lime & Shale	3320	3470		
Lime & Shale	3470	3550		
Lime & Shale	3550	3636		
Lime & Shale	3636	3715		
Lime & Shale	3715	3818		
Lime & Shale	3818	3876		
Lime	3876			
T.D.	3876			

USE ADDITIONAL SHEETS, IF NECESSARY, TO COMPLETE WELL RECORD.

Date Received	<div style="font-size: 1.5em; font-family: cursive; margin-bottom: 5px;">K. T. Woodman</div> <hr/> <div style="display: flex; justify-content: space-between;"> K.T. Woodman Signature </div> <hr/> <div style="display: flex; justify-content: space-between;"> Partner Title </div> <hr/> <div style="text-align: right;"> 8-12-81 </div> <hr/> <div style="text-align: right;"> Date </div>
---------------	---