


WELL PLUGGING RECORD

Give All Information Completely
Make Required Affidavit
Mail or Deliver Report to:
Conservation Division
State Corporation Commission
800 Bittling Building
Wichita, Kansas

NORTH

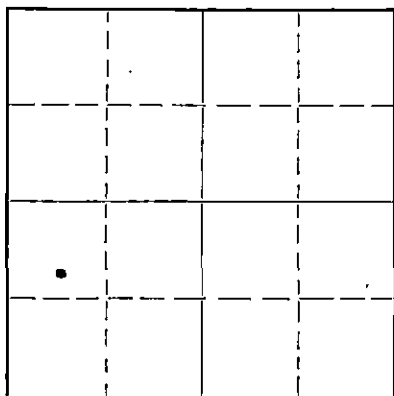

Locate well correctly on above
Section Plat

Stafford.....County. Sec. 9 Twp. 22 Rge. 14 (E) W. (W)
Location as "NE/CNW $\frac{1}{4}$ SW $\frac{1}{4}$ " or footage from lines C-S/2-NW-SW
Lease Owner Petroleum, Incorporated
Lease Name Strobel "B" Well No. 2
Office Address 305 East Third, Wichita 2, Kansas
Character of Well (completed as Oil, Gas or Dry Hole) Dry Hole
Date well completed January 1 19.53
Application for plugging filed January 9 19.53
Application for plugging approved January 26 19.53
Plugging commenced January 26 19.53
Plugging completed January 31 19.53
Reason for abandonment of well or producing formation
No producible shows
If a producing well is abandoned, date of last production ----- 19.-----
Was permission obtained from the Conservation Division or its agents before plugging was commenced? Yes

Name of Conservation Agent who supervised plugging of this well M. A. Rives
Producing formation --- Depth to top --- Bottom --- Total-Depth of Well 3,875! Feet
Show depth and thickness of all water, oil and gas formations.

OIL, GAS OR WATER RECORDS

CASING RECORD

Formation	Content	From	To	Size	Put In	Pulled Out
				8-5/8"	238'	None
				5 1/2"	3,750'	3,350'

Describe in detail the manner in which the well was plugged, indicating where the mud fluid was placed and the method or methods used in introducing it into the hole. If cement or other plugs were used, state the character of same and depth placed, from ----- feet to ----- feet for each plug set.

(Drilled Out To 3,718')

Filled hole with crushed rock from 3,718' to 3,650'.
Placed five sacks cement from 3,650' to 3,615'. Filled hole with mud from 3,615' to 238'. Placed 60 sacks of cement from 238' to base of well cellar.

2-4-53
RECEIVED
STATE CORPORATION COMMISSION
FEB 4 - 1953
CONSERVATION DIVISION
Wichita, Kansas

(If additional description is necessary, use BACK of this sheet)
Correspondence regarding this well should be addressed to PETROLEUM, Inc.
Address Rural Route 2, Great Bend, Kansas.

STATE OF Kansas, COUNTY OF Sedgewick, ss.
Paul B. Shivel (employee of owner) or (owner or operator) of the above-described well,
being first duly sworn on oath, says: That I have knowledge of the facts, statements, and matters herein contained and the log of the above-described well as filed and that the same are true and correct. So help me God.
(Signature) *Paul B. Shivel*
R.F.D.-2, Great Bend, Kansas
(Address)

SUBSCRIBED AND SWORN to before me this 31 day of January, 19.53.
Charlotte Harmon
Notary Public.

My commission expires October 13, 1954
22-7877-a 4-49-10M

PLUGGING
FILE SEC 9 T22 R 14 W
BOOK PAGE 71 LINE 32

DRILLER'S LOG STROBEL 'B' #2

Petroleum, Inc., Operator	Section 9, Twp. 22S, Rge. 14W
Garvey Drilling Company, Contractor	Location: C. S/2 NW SW
Drilling Commenced: December 16, 1952	County: Stafford County, Kansas
Drilling Completed: December 29, 1952	R.T.D.: 3875'
Casing Record: 8 5/8" O 238' w/175	Production: D & A
5 1/2" O 3750' w/50 sax	

Figures below indicate bottom of formation:

190 Sand
 238 Shale & Shells
 867 Shale & Red Bed
 895 Anhydrite
 1590 Shale & Shells
 1640 Salt & Shale
 1745 Shale & Shells
 1965 Lime & Shale
 2125 Lime
 3410 Lime & Shale
 3740 Lime
 3810 Lime & Chert
 3875 Lime

Tops:

Heebner: 3342 (-1398)
 Brown Lime: 3462 (-1513)
 Lansing: 3473 (-1524)
 Arbuckle: 3868 (-1919)

DST #1, 3590-3605, open 40 mins., rec. 5' mud, 0# BHP.

DST #2, 3655-71, open 1 hr., rec. 40' mud, trace oil cut mud, 1050# BHP.

3875' R.T.D.

I hereby certify that this is a true and correct log of the above mentioned well.

PETROLEUM, INC.

By W W Fish

REGISTERED
 STATE CORPORATION
 FEB 4 - 1953
 CONSERVATION DIVISION

STATE OF KANSAS)
) SS:
 COUNTY OF SEDGWICK)

Subscribed to and sworn to before me, a Notary Public, in said County and State, this 6th day of January, 1953.

Charlotte Redman
 Notary Public

My commission expires: October 13, 1954.

PLUGGING
 FILE NO. 4 T 22 144
 BOOK PAGE 71 LINE 32