

WELL PLUGGING RECORD

Give All Information Completely
Make Required Affidavit
Mail or Deliver Report to:
Conservation Division
State Corporation Commission
800 Bitting Building
Wichita, Kansas

Stafford County. Sec. 7 Twp. 22S Rge. (E) 14 (W)

Location as "NE/CNW/SW" or footage from lines SW SW NE

Lease Owner Stickle Drilling Company

Lease Name Estes Well No. 1

Office Address 507 Bitting Building, Wichita 2, Kansas

Character of Well (completed as Oil, Gas or Dry Hole) Dry Hole

Date well completed 3 March 19 56

Application for plugging filed 3 March 19 56

Application for plugging approved 3 March 19 56


Plugging commenced 3 March 19 56

Plugging completed 3 March 19 56

Reason for abandonment of well or producing formation
Dry Hole

If a producing well is abandoned, date of last production 19

Was permission obtained from the Conservation Division or its agents before plugging was commenced? Yes

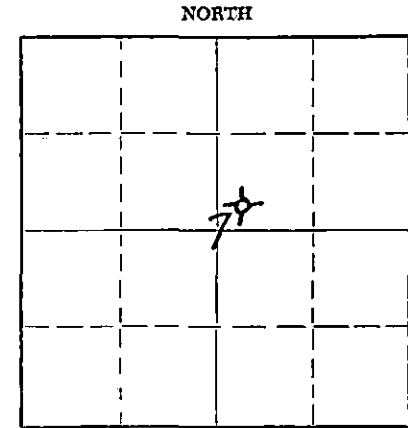

Locate well correctly on above Section Plat

Name of Conservation Agent who supervised plugging of this well R.M. Brundage, Hoisington, Kans.

Producing formation None Depth to top Bottom Total Depth of Well 3955 Feet

Show depth and thickness of all water, oil and gas formations.

OIL, GAS OR WATER RECORDS

CASING RECORD

FORMATION	CONTENT	FROM	TO	SIZE	PUT IN	PULLED OUT
Surface	water	0	250	8 5/8	299	None

Describe in detail the manner in which the well was plugged, indicating where the mud fluid was placed and the method or methods used in introducing it into the hole. If cement or other plugs were used, state the character of same and depth placed, from feet to feet for each plug set.

Heavy rotary mud from total depth to 270 feet through drill pipe

Halliburton plug and 1/3 sack hulls placed at 270 feet.

35 sacks cement placed on plug through drill pipe by Halliburton

Heavy rotary mud to 40 feet.

Halliburton plug and 1/3 sack hulls @ 40 feet with 15 sacks cement placed on plug through drill pipe by Halliburton.

(If additional description is necessary, use BACK of this sheet)

Name of Plugging Contractor Stickle Drilling Company
Address 507 Bitting Building, Wichita 2, Kansas

STATE OF Kansas, COUNTY OF Sedgwick, ss.
R.B. Parriott (employee of owner) or (owner or operator) of the above-described well, being first duly sworn on oath, says: That I have knowledge of the facts, statements, and matters herein contained and the log of the above-described well as filed and that the same are true and correct. So help me God.

(Signature) R.B. Parriott
507 Bitting Building, Wichita, Kans.
(Address)

SUBSCRIBED AND SWORN TO before me this 5th day of March, 19 56

My commission expires August 22, 1957

24-2675-5 2-52-20M

PLUGGING
FILE SEC 7 T 22 R 14W
BOOK PAGE 43 LINE 35

RECEIVED
CONSERVATION DIVISION
Wichita, Kansas
3-9-56

Notary Public.

15-185.00931-0000

Stickle Drilling Company Etal
Tulsa, Oklahoma

Tulsa, Oklahoma
March 7, 1956

CONTRACTOR: Stickle Drilling Company
Drilling Commenced: February 20, 1956
Drilling Completed: March 3, 1956

Estes #1 SW SW NE Sec.
7-22S-14W, Stafford
County, Kansas

DRILLERS LOG

Depth Figures Indicate Base of Formation

Sand & Shale	301
Red Bed, Shae & Shells	1525
Red Bed & Shale	1765
Lime	1880
Lime & Shale	2420
Shale & Lime	2625
Lime & Shale	3125
Lime	3220
Lime & Shale	3365
Douglas	3460
Sandy Shale	3477
Lime & Shale	3595
Lime	3715
Marmaton	3750
Lime & Shale	3782
Conglomerate	3791
Lime	3833
Lime & Shale Sand	3885
Shale & Lime	3925
Lime	3955 TD

I, Fred E. Stickle hereby certify the above to be a true and complete Drillers Log of Stickle Drilling Company Etal, Estes #1 SW SW NE Section 7-22S-14W, Stafford County, Kansas.

Fred E. Stickle
Fred E. Stickle

Lillian T. Bonham

Notary Public

February 13, 1960

My Commission Expires.

STATE COMMISSION

MAR 11 1956

PLUGGING CONSERVATION DIVISION
Wichita, Kansas
FILE SEC 7-22-314W
BOOK PAGE 43 LINE 35