

STATE OF KANSAS  
STATE CORPORATION COMMISSION


WELL PLUGGING RECORD

Give All Information Completely  
Make Required Affidavit  
Mail or Deliver Report to:  
Conservation Division  
State Corporation Commission  
800 Bittling Building  
Wichita, Kansas

OR  
FORMATION PLUGGING RECORD

Strike out upper line  
when reporting plug-  
ging off formations.

STAFFORD County. Sec. 21 Twp. 22 Rge. (E) 13 (W)  
Location as "NE 1/4 NW 1/4 SW 1/4" or footage from lines SW SW NW  
Lease Owner. Graham-Messman-Rinehart Oil Company  
Lease Name. Hahn Well No. 1  
Office Address. 204 No. Market, Wichita 2, Kansas.  
Character of Well (completed as Oil, Gas or Dry Hole) Dry Hole  
Date well completed 2-14 19 51  
Application for plugging filed 2-21 19 51  
Application for plugging approved 2-19 19 51  
Plugging commenced 2-14 19 51  
Plugging completed 2-15 19 51  
Reason for abandonment of well or producing formation

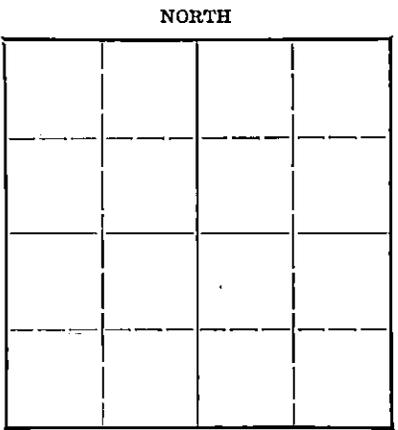

Locate well correctly on above  
Section Plat

Name of Conservation Agent who supervised plugging of this well C. D. Stough  
Producing formation Depth to top Bottom Total Depth of Well Feet  
Show depth and thickness of all water, oil and gas formations.

OIL, GAS OR WATER RECORDS CASING RECORD

Formation	Content	From	To	Size	Put In	Pulled Out
				8 5/8	300	None

Describe in detail the manner in which the well was plugged, indicating where the mud fluid was placed and the method or methods used in introducing it into the hold. If cement or other plugs were used, state the character of same and depth placed, from feet to feet for each plug set.

Mud to 290' set bridge at  
290' x 15 sacks cement, mud to 30'  
set bridge at 30', 10 sacks cement mud  
to surface.

RECEIVED  
STATE CORPORATION COMMISSION  
FEB 23 1951  
CONSERVATION DIVISION  
WICHITA, KANSAS

2-23-51

(If additional description is necessary, use BACK of this sheet)  
Correspondence regarding this well should be addressed to GRAHAM-MESSMAN-RINEHART OIL CO.  
Address 204 N. Market  
Wichita, Kansas

STATE OF KANSAS, COUNTY OF SEDGWICK, SS.  
J. A. GILLILAND (employee of owner) of the above-described well,

being first duly sworn on oath, says: That I have knowledge of the facts, statements, and matters herein contained and the log of the above-described well as filed and that the same are true and correct. So help me God.

(Signature) J. A. Gilliland

204 N. Market, Wichita 2, Kansas  
(Address)

SUBSCRIBED AND SWORN to before me this 21st day of February, 19 51

Geraldine F. Ward  
Notary Public.

My commission expires 9-13-54

PLUGGING  
FILE SEC-21 T-22 R-13  
BOOK PAGE 6 LINE 45

HAHN # 11WELL RECORD

Location: SW SW NW 21-22-13W  
Stafford Co., Kans.

Commenced: 2-2-51

Operator: G-M-R Oil Co.  
204 No. Mkt.  
Wichita 2, Kans.

Completed: 2-15-51

Elevation: 1900 D. F.  
1898 Gr

Contractor: " " "

Production: Dry Hole

Casing Record: 8 5/8" 300' Surface Pipe  
175 sks cement

LOG

(Figures indicate bottom of formation)

Sand & Clay	265
Shale	758
Anhydrite	790
Shale & Shells	895
Shale	1395
Shale & Shells	1613
Shale & Lime	1706
Lime & Shale	2520
Shale & Lime	2635
Lime & Shale	3050
Lime	3110
Lime & Shale	3282
Lime	3335
Lime & Shale	3400
Shale & Lime	3455
Lime	3680
Lime & Shale	3774
Chert & Shale	3810
Viola	3771
Lime & Shale	3851
Lime	3901
T. D.	3901

TOPS

Topeka	2988
Heebner	3302
Brn. Lime	3428
Lansing	3440 (-1537)
Simpson	3794
Arbuckle	3851 (-1948)

The undersigned, GRAHAM-MESSMAN-RINEHART OIL COMPANY, hereby certifies that the above Log is a true and correct Log of the formation encountered in drilling the above well as reflected by the Daily Drilling Reports.

GRAHAM-MESSMAN-RINEHART OIL CO.

BY

*J. A. Gilliland*  
J. A. Gilliland, Office Mgr.

Subscribed and sworn to before me  
this 21st day of February, 1951.

*Geraldine F. Ward*

Notary Public

My Commission expires: 9-13-54

RECEIVED  
STATE CORPORATION COMMISSION  
FEB 23 1951  
CONSERVATION DIVISION  
Wichita, Kansas

