

WELL PLUGGING RECORD

Give All Information Completely
Make Required Affidavit
Mail or Deliver Report to:
Conservation Division
State Corporation Commission
211 No. Broadway
Wichita, Kansas

Stafford County, Sec. 21 Twp. 22S Rge. 13W (E) (W)

Location as "NE/CNW/SW" or footage from lines NE NW NE

Lease Owner E. K. Edmiston

Lease Name Alpers Well No. -1-

Office Address 501 First National Bank Building, Wichita, Ks.

Character of Well (completed as Oil, Gas or Dry Hole) dry hole

Date well completed September 30, 1963 19

Application for plugging filed September 30, 1963 19

Application for plugging approved September 30, 1963 19


Plugging commenced September 30, 1963 19

Plugging completed September 30, 1963 19

Reason for abandonment of well or producing formation dry hole

If a producing well is abandoned, date of last production --- 19

Was permission obtained from the Conservation Division or its agents before plugging was commenced? yes

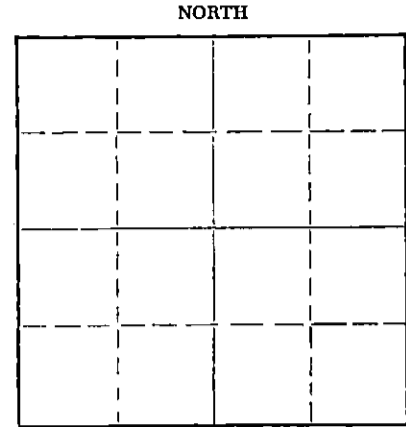

Locate well correctly on above Section Plat

Name of Conservation Agent who supervised plugging of this well A. Elving

Producing formation --- Depth to top --- Bottom --- Total Depth of Well 3870 Feet

Show depth and thickness of all water, oil and gas formations.

OIL, GAS OR WATER RECORDS

CASING RECORD

FORMATION	CONTENT	FROM	TO	SIZE	PUT IN	PULLED OUT
				8-5/8	244	

Describe in detail the manner in which the well was plugged, indicating where the mud fluid was placed and the method or methods used in introducing it into the hole. If cement or other plugs were used, state the character of same and depth placed, from --- feet to --- feet for each plug set.

Set plug at 240 feet, cemented with 25 sacks cement and plug at 40 feet, cemented with 10 sacks cement

RECEIVED
STATE CORPORATION COMMISSION

OCT 10 1963

10-10-63

CONSERVATION DIVISION
Wichita, Kansas

(If additional description is necessary, use BACK of this sheet)

Name of Plugging Contractor E. K. Edmiston Drilling Co., Inc.

Address 501 First National Bank Building, Wichita, Kansas

STATE OF KANSAS, COUNTY OF SEDGWICK, ss.

E. K. Edmiston, ~~owner~~ owner or operator of the above-described well, being first duly sworn on oath, says: That I have knowledge of the facts, statements and matters herein contained and the log of the above-described well as filed and that the same are true and correct. So help me God.

(Signature)

501 First National Bank Building, Wichita, Ks.
(Address)

SUBSCRIBED AND SWORN TO before me this 8th day of October, 1963

A. B. Bargaen Notary Public.

My commission expires August 25, 1964



D R I L L E R ' S L O G

Company: E. K. Edmiston
 501 First National Bank Building
 Wichita, Kansas

Rotary Drilling Commenced: September 19, 1963

Rotary Drilling Completed: September 30, 1963

Well Name: ALPERS No. 1
 NE NW NE Section 21-22S-13W
 Stafford County, Kansas

Contractor: E. K. Edmiston Drilling Co., Inc.
 501 First National Bank Building
 Wichita, Kansas

Casing record: 8-5/8" at 244' with 250 sacks cement

L O G

Measurements from top of Rotary Bushing

Sand and Shale	0 -	244
Shale		767
Anhydrite		797
Shale and Shells		1320
Shale and Lime		1734
Lime and Shale		1884
Lime		2195
Shale and Lime		2555
Lime and Shale		3390
Lime		3705
Lime and Chert		3785
Lime		3870 RTD

RECEIVED
STATE CORPORATION COMMISSION

OCT 10 1963

CONSERVATION DIVISION
Wichita, Kansas

The undersigned, E. K. Edmiston, President of E. K. Edmiston Drilling Co., Inc., hereby certifies on behalf of said company that the above log is a true and correct log of the formations encountered in drilling the above well as reflected by the daily drilling reports.

E. K. EDMISTON DRILLING CO., INC.

By: *E. K. Edmiston*
E. K. Edmiston, President

STATE OF KANSAS,
SS:
SEDGWICK COUNTY,

BE IT REMEMBERED that on this 3rd day of October, 1963, before me, the undersigned, a Notary Public duly commissioned in and for the State and County aforesaid, came E. K. Edmiston, known to me to be the same person who executed the foregoing instrument as President and on behalf of the E. K. Edmiston Drilling Co., Inc., and he duly acknowledged the execution of the same for himself and for said company.

IN WITNESS WHEREOF, I have hereunto set my hand and official seal on the day and year last above written.



A. B. Barga
A. B. Barga, Notary Public

My commission expires
August 25, 1964