

STATE OF KANSAS
STATE CORPORATION COMMISSION
200 Colorado Derby Bldg.
Wichita, Kansas 67202


Form CP-4
Rev. 12-15-80
COMMISSION

JAN 13 1984
1-3-84
ENGINEERING DIVISION
Wichita, Kansas

WELL PLUGGING RECORD

Give All Information Completely
Make Required Affidavit

COUNTY Stafford SEC. 21 TWP. 22S RGE. 13 ~~E/W~~
Location as in quarters or footage from lines:
NW NE SW

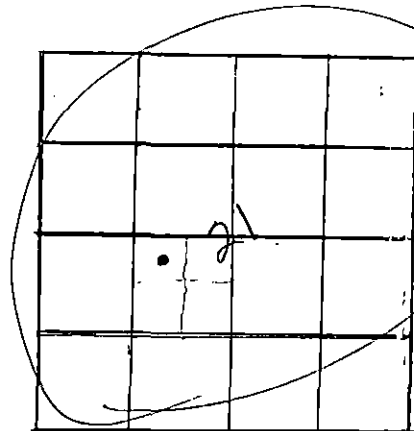

Locate Well
correctly on above
Section Platt.

Lease Owner Glacier Petroleum Company, Inc.
Lease Name Rusco Well No. 1
Office Address P.O. Box 577, Emporia, KS 66801
Character of Well (Completed as Oil, Gas or Dry Hole): Dry Hole
Date Well Completed 10-02-83
Application for plugging filed yes
Plugging commenced 10-02-83
Plugging completed 10-02-83
Reason for abandonment of well or producing formation Dry Hole

Was permission obtained from the Conservation Division or it's
Agent's before plugging was commenced? yes (CL)

Name of Conservation Agent who supervised plugging of this well Bob Tarbutton

Producing formation _____ Depth to top _____ bottom T.D. 3,870'

Show depth and thickness of all water, oil and gas formations.

OIL, GAS OR WATER RECORDS

Casing Record

Formation	Content	From	To	Size	Put in	Pulled Out
				8-5/8"	322'	

Describe in detail the manner in which the well was plugged, indicating where the mud fluid was placed and the method or methods used in introducing it into the hold. If cement or other plugs were used, state the character of same and depth placed, from _____ feet to _____ feet for each plug set.

Mud to 570' hull plug, 50 sacks cement. Mud to 390' hull plug, 40 sacks cement.
Mud to 40' hull plug, 10 sacks cement.

(If additional description is necessary, use BACK of this sheet)

Name of Plugging Contractor Glacier Drilling Company, Inc.

STATE OF Kansas COUNTY OF Lyon, ss.
Loren D. Martin (employee of owner) or (owner or operator) of the
above-described well, being first duly sworn on oath, says: That I have knowledge of the
facts, statements, and matters herein contained and the log of the above-described well as
filed and that the same are true and correct. So help me God.

(Signature) Loren D. Martin, agent
825 Commercial
Englewood, KS.
(Address)

SUBSCRIBED AND SWORN TO before me this 8th day of October, 19 83



Ethel M. Grimwood
Notary Public.

My Commission expires: _____