


STATE OF KANSAS
STATE CORPORATION COMMISSION

WELL PLUGGING RECORD

Give All Information Completely
Make Required Affidavit
Mail or Deliver Report to:
Conservation Division
State Corporation Commission
212 No. Market
Wichita, Kansas

Stafford County. Sec. 22 Twp. 22S Rge. 13 (E) 13 (W)

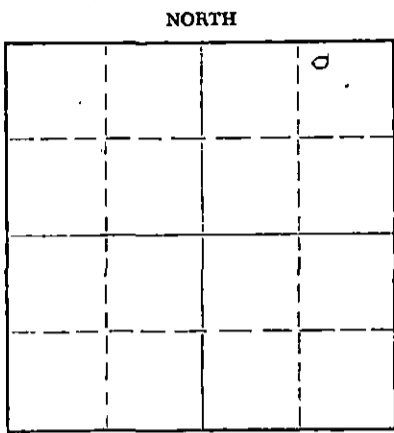

Locate well correctly on above
Section Plat

Location as "NE/CNW/SW" or footage from lines _____
Lease Owner Midwestern Supply, Inc.
Lease Name Master Well No. 1
Office Address 203 Brown Building, Wichita, Kansas
Character of Well (completed as Oil, Gas or Dry Hole) Oil
Date well completed December 19 64
Application for plugging filed April 2 19 69
Application for plugging approved April 3 19 69
Plugging commenced April 4 19 69
Plugging completed April 9 19 69
Reason for abandonment of well or producing formation Non-commercial

If a producing well is abandoned, date of last production _____ 19 _____
Was permission obtained from the Conservation Division or its agents before plugging was commenced? Yes

Name of Conservation Agent who supervised plugging of this well Ralph Warren
Producing formation Arbuckle Depth to top _____ Bottom _____ Total Depth of Well 3830 Feet
Show depth and thickness of all water, oil and gas formations.

OIL, GAS OR WATER RECORDS

CASING RECORD

FORMATION	CONTENT	FROM	TO	SIZE	PUT IN	PULLED OUT
				8-5/8"	270	none
				5-1/2"	3795	3133

Describe in detail the manner in which the well was plugged, indicating where the mud fluid was placed and the method or methods used in introducing it into the hole. If cement or other plugs were used, state the character of same and depth placed, from _____ feet to _____ feet for each plug set.

5 1/2' casing @ 3795' TD 3830'
Bridge @ 3785'
Rock 3785-3775'
5 sacks cement @ 3775'
Shot pipe @ 3105'
Pulled 3133' 5 1/2' casing
Bridge @ 260'
Rock 260-245'
30 sacks cement @ 245'
Mud to 30'
10 sacks cement from 30' to 4' below ground level
Plugging complete

RECEIVED
STATE CORPORATION COMMISSION
MAY 1 1969
CONSERVATION DIVISION
Wichita, Kansas
5-1-69

(If additional description is necessary, use BACK of this sheet)

Name of Plugging Contractor Braden-Deem, Inc.
Address 210 One Twenty Bldg., Wichita, Kansas 67202

STATE OF Kansas, COUNTY OF Sedgwick, ss.
Doy C. Deem (employee of owner) or (owner or operator) of the above-described well, being first duly sworn on oath, says: That I have knowledge of the facts, statements, and matters herein contained and the log of the above-described well as filed and that the same are true and correct. So help me God.

(Signature) _____
210 One Twenty Bldg., Wichita, Kansas
(Address)

SUBSCRIBED AND SWORN TO before me this 25 day of April, 19 69

My commission expires March 21, 1970

Notary Public.

KANSAS GEOLOGICAL SOCIETY
KANSAS WELL LOG BUREAU - KANSAS WELL SAMPLE BUREAU
KANSAS GEOLOGICAL SOCIETY BUILDING
508 EAST MURDOCK - WICHITA, KANSAS

COPY

COMPANY VARN PET. CO., ET AL

SEC. 22 T. 22 R. 13W
LOC. NW NE NE

FARM Mater NO. 1

COUNTY Stafford

TOTAL DEPTH 3809'


COMM. 12-7-64

COMP. 2-11-65

SHOT OR TREATED

CONTRACTOR Gabbert-Jones

ISSUED 12-9-67

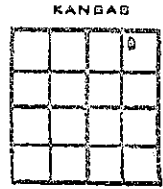

CASING

20	10	
15	5/8" 270'	cem w/ 225 sx
12	6	
13	5 1/2" 3795'	cem w/ 110 sx

ELEVATION 1893' KB

PRODUCTION 25 BOPD/ Acs 3795-3809

FIGURES INDICATE BOTTOM OF FORMATIONS

COMPLETE DRILLERS LOG NOT AVAILABLE

TOPS: LOG

Heebner	3244
Brown lime	3375
Lansing	3394
Viola	3696
Simpson shale	3732
Simpson sand	3754
Arbuckle	3793
Total Depth	3809

3793
1893
-1900

RECEIVED
STATE CORPORATION COMMISSION
APR 3 1969
CONSERVATION DIVISION
Wichita, Kansas