

STATE OF KANSAS
STATE CORPORATION COMMISSION

WELL PLUGGING RECORD

Give All Information Completely
Make Required Affidavit
Mail or Deliver Report to:
Conservation Division
State Corporation Commission
211 No. Broadway
Wichita, Kansas

Stafford County, Sec. 22 Twp. 22 Rge. 13 (E) W (W)

Location as "NE/CNW/SW" or footage from lines NE NE NW

Lease Owner L. K. Parrish

Lease Name Hahn Well No. 1

Office Address Fourth National Bank Bldg., Wichita, Kansas

Character of Well (completed as Oil, Gas or Dry Hole) Dry Hole

Date well completed October 2, 1963 19

Application for plugging filed October 2, 1963 19

Application for plugging approved October 2, 1963 19


Plugging commenced October 2, 1963 19

Plugging completed October 2, 1963 19

Reason for abandonment of well or producing formation Too low structurally

If a producing well is abandoned, date of last production _____ 19

Was permission obtained from the Conservation Division or its agents before plugging was commenced? Yes

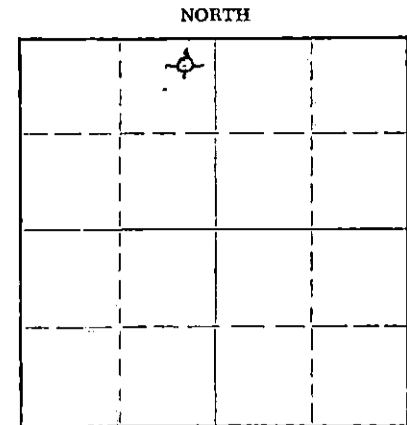

Locate well correctly on above Section Plat

Name of Conservation Agent who supervised plugging of this well Archie V. Elving, Pratt, Kansas

Producing formation _____ Depth to top _____ Bottom _____ Total Depth of Well 3821 Feet

Show depth and thickness of all water, oil and gas formations.

OIL, GAS OR WATER RECORDS

CASING RECORD

FORMATION	CONTENT	FROM	TO	SIZE	PUT IN	PULLED OUT
				8-5/8"	313.98'	None

Describe in detail the manner in which the well was plugged, indicating where the mud fluid was placed and the method or methods used in introducing it into the hole. If cement or other plugs were used, state the character of same and depth placed, from _____ feet to _____ feet for each plug set.

Filled hole with heavy mud to 297'. Set plug. Put in 25 sacks cement. Filled hole with heavy mud to 40. Set plug. Filled to top with 10 sacks cement.

RECEIVED
STATE CORPORATION COMMISSION

OCT 9 1963

10-9-63

CONSERVATION DIVISION
Wichita, Kansas

Name of Plugging Contractor C-G Drilling Co. (If additional description is necessary, use BACK of this sheet)
Address 107 Rule Bldg., Wichita, Kansas

STATE OF KANSAS, COUNTY OF SEDGWICK, ss. Jay H. Galloway

(employee of owner) or (owner or operator) of the above-described well, being first duly sworn on oath, says: That I have knowledge of the facts, statements, and matters herein contained and the log of the above-described well as filed and that the same are true and correct. So help me God.

(Signature) Jay H. Galloway

107 Rule Bldg

(Address)

SUBSCRIBED AND SWORN TO before me this 7th day of October, 19 63

My commission expires May 20, 1967

Vicky Jacobs
Notary Public.



W E L L L O G

OPERATOR L. K. PARRISH

SEC. 22-22-13W

WELL NAME HAHN #1

LOC. NE NE NW

TOTAL DEPTH 3821'

COUNTY STAFFORD

COMM. 9/21/63

COMP. 10/2/63

STATE KANSAS

RIG NO. 2

ELEVATION 1900 K.B.

CASING: Set 313/98' (9 jts) 8-5/8" OD Surface casing.

PRODUCTION: Dry & Abandoned

All measurements taken from the top of rotary bushing.

FROM	TO	FORMATION	DEVIATION FROM VERTICAL	REMARKS:
0	250	Sand	500' - 0°	
250	312	Shale		
312	745	Red Bed		
745	780	Anhydrite		
780	1590	Shale & shells	1000' - 0°	
1590	3410	Lime & Shale	1500' - 0°	
3410	3721	Lime	2000' - 0°	DST 3519-3535'
3721	3762	Chert.		DST 3582-3598'
3762	3807	Lime & Shale		DST 3747-3807'
3807	3821	Shale & Arbuckle		DST 3810-3821'

RECEIVED
STATE CORPORATION COMMISSION

OCT 9 1963

CONSERVATION DIVISION
Wichita, Kansas

STATE OF KANSAS)
COUNTY OF SEDGWICK) SS.

The undersigned hereby certifies that to the best of his knowledge and belief, the above facts are true and correct.

C-G DRILLING CO.

By

Jay H. Galloway
Jay H. Galloway

SUBSCRIBED AND SWORN TO, BEFORE ME, THIS 14th day of October, 1963.

My commission expires:
May 20, 1967

Vicky Jacobs
Vicky Jacobs - Notary Public