

STATE OF KANSAS
STATE CORPORATION COMMISSION

Form CP-4


Give All Information Completely
Make Required Affidavit
Mail or Deliver Report to:
Conservation Division
State Corporation Commission
212 No. Market
Wichita, Kansas

WELL PLUGGING RECORD

Stafford County, Sec. 22 Twp. 22 Rge. (E) 13(W)

Location as "NE/CNW/SW" or footage from lines NE SE NW
Lease Owner L. K. Parrish
Lease Name Williams Well No. 1
Office Address 714 Fourth National Building, Wichita, Kansas
Character of Well (completed as Oil, Gas or Dry Hole) oil
Date well completed 19
Application for plugging filed August 5 1968
Application for plugging approved 19
Plugging commenced August 6 1968
Plugging completed August 9 1968
Reason for abandonment of well or producing formation depleted

NORTH

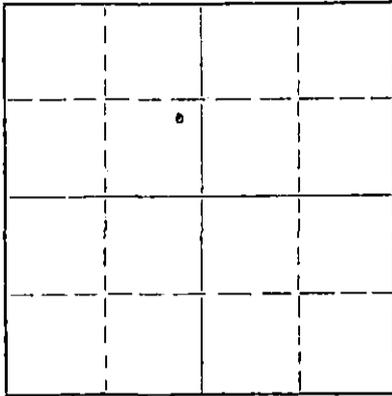

Locate well correctly on above
Section Plat

If a producing well is abandoned, date of last production 19
Was permission obtained from the Conservation Division or its agents before plugging was commenced? yes

Name of Conservation Agent who supervised plugging of this well Ralph Warren
Producing formation _____ Depth to top _____ Bottom _____ Total Depth of Well 3833 Feet
Show depth and thickness of all water, oil and gas formations.

OIL, GAS OR WATER RECORDS

CASING RECORD

FORMATION	CONTENT	FROM	TO	SIZE	PUT IN	PULLED OUT
		0	310'	8 5/8"	310'	none
		0	3823'	5 1/2"	3823'	2657.93

Describe in detail the manner in which the well was plugged, indicating where the mud fluid was placed and the method or methods used in introducing it into the hole. If cement or other plugs were used, state the character of same and depth placed, from _____ feet to _____ feet for each plug set.

Pushed plug to 3750', set 10' sand bridge and dumped 5 sacks cement.

Pushed plug to 285', set 10' rock bridge and dumped 5 sacks of cement.
Bailed down hole and dumped 25 sacks of cement. Filled hole with mud to 40' and capped hole with 10 sacks of cement.

RECEIVED
STATE CORPORATION COMMISSION
AUG 21 1968
CONSERVATION DIVISION
Wichita, Kansas

8-21-68

(If additional description is necessary, use BACK of this sheet)
Name of Plugging Contractor Pipe Pullers, Inc.
Address Box 486, Ellinwood, Kansas

STATE OF Kansas, COUNTY OF Barton, ss.
Evelyn Roth (employee of owner) or (owner or operator) of the above-described well, being first duly sworn on oath, says: That I have knowledge of the facts, statements, and matters herein contained and the log of the above-described well as filed and that the same are true and correct. So help me God.

(Signature) Evelyn Roth
Ellinwood, Kansas
(Address)

SUBSCRIBED AND SWORN TO before me this 20th day of August, 1968

My commission expires Feb. 10, 1971
George A. Meyer Notary Public.

Plugging application and
Plugging report will
follow

15185-19358-0000

W E L L L O G

OPERATOR L. K. Parrish SEC. 22-22S-13W
 WELL NAME Williams #1 LOC. NE SE NW
 TOTAL DEPTH 3833' COUNTY Stafford
 COMM. 12/3/63 COMP. 12/14/63 STATE Kansas
 RIG NO. #2 ELEVATION 1898 K. B.
 CASING: Set 313' (9 jts.) 8-5/8" OD Surface PRODUCTION: Producing
 Casing.
 Set 5-1/2" OD Casing @3823' (121 jts.)

All measurements taken from the top of rotary bushing.

FROM	TO	FORMATION	DEVIATION FROM VERTICAL	REMARKS:
0	195	Sand		
195	310	Shale		
310	750	Red Bed	500' - 3/4°	
750	780	Anhydrite		
780	1720	Shale-Shells	1000' - 1/2°	
1720	1930	Shale-Lime	1500' - 3/4°	
1930	2330	Lime-Shale	2000' - 1/4°	
2330	2825	Shale-Lime	2500' - 0°	
2825	3075	Lime-Shale	3000' - 1/4°	
3075	3165	Lime		
3165	3455	Lime-Shale		
3455	3655	Lime		Dst #1 3590-3606
3655	3710	Lime-Chert		DST #2 3746-94
3710	3750	Chert		DST #3 3810-22
3750	3794	Simpson Shale-Sand		
3794	3800	Shale		
3800	3808	Shale-Lime		
3808	3822	Arbuckle		
3822	3833	Arbuckle		

RECEIVED
 STATE CORPORATION COMMISSION
 AUG 6 1968
 CONSERVATION DIVISION
 Wichita, Kansas

STATE OF KANSAS)
 COUNTY OF SEDGWICK) SS.

The undersigned hereby certifies that to the best of his knowledge and belief, the above facts are true and correct.

C-G DRILLING CO.

By G. F. Galloway

G. F. Galloway

SUBSCRIBED AND SWORN TO, BEFORE ME, THIS 20 day of December, 1963.

My commission expires: May 20, 1963

Vicky Jacobs
 Vicky Jacobs - Notary Public

