


STATE OF KANSAS
STATE CORPORATION COMMISSION

WELL PLUGGING RECORD

Give All Information Completely
Make Required Affidavit
Mail or Deliver Report to:
Conservation Division
State Corporation Commission
211 No. Broadway
Wichita, Kansas

Reno County, Sec. 18 Twp. 22 Rge. 9 ~~W~~ (W)
Location as "NE/CNWSW" or footage from lines SW NE NE
Lease Owner White & Ellis, etal
Lease Name Wisby Well No. 2
Office Address Box 448, El Dorado, Kansas
Character of Well (completed as Oil, Gas or Dry Hole) Dry
Date well completed June 5 1957
Application for plugging filed June 5 1957
Application for plugging approved June 5 1957
Plugging commenced June 5 1957
Plugging completed June 5 1957
Reason for abandonment of well or producing formation _____

NORTH

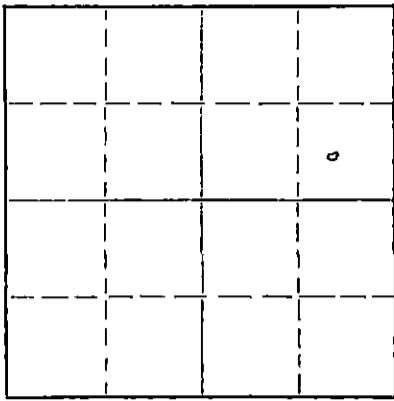

Locate well correctly on above
Section Plat

If a producing well is abandoned, date of last production _____ 19____
Was permission obtained from the Conservation Division or its agents before plugging was commenced? Yes

Name of Conservation Agent who supervised plugging of this well Ruel Durkee
Producing formation _____ Depth to top _____ Bottom _____ Total Depth of Well 3632 1/2 Feet
Show depth and thickness of all water, oil and gas formations.

OIL, GAS OR WATER RECORDS

CASING RECORD

FORMATION	CONTENT	FROM	TO	SIZE	PUT IN	PULLED OUT
				8 5/8"	239'	None

Describe in detail the manner in which the well was plugged, indicating where the mud fluid was placed and the method or methods used in introducing it into the hole. If cement or other plugs were used, state the character of same and depth placed, from _____ feet to _____ feet for each plug set.

Hole filled with heavy rotary mud to 239 feet.
Rock bridge at 239 ft. with 15 sacks cement on
bridge. Hole filled with heavy rotary mud to
30 ft. Rock bridge at 30 ft. with 5 sacks cement
on bridge.

(If additional description is necessary, use BACK of this sheet)
Name of Plugging Contractor White & Ellis Drilling, Inc., License #209
Address Box 448, El Dorado, Kansas

STATE OF Kansas, COUNTY OF Butler, ss.
Bruce Auer (employee of owner) or ~~owner or operator~~ of the above-described well, being first duly sworn on oath, says: That I have knowledge of the facts, statements, and matters herein contained and the log of the above-described well as filed and that the same are true and correct. So help me God.

(Signature) Bruce Auer Bruce Auer
Box 448, El Dorado, Kansas (Address)

SUBSCRIBED AND SWORN TO before me this 7th day of June, 19 57

My commission expires April 14, 1958

Dale R. Daniel
Dale R. Daniel, Notary Public.

PLUGGING
FILE SEC. 18 T. 22 R. 9W
BOOK PAGE 19 LINE 22

RECEIVED
STATE CORPORATION COMMISSION
8-8-57
AUG 8 1957

CONSERVATION DIVISION
Wichita, Kansas

Casing Record

8 5/8 " 239' cemented
W/ 200 sacks

Total depth 3632½

Location: S. NE NE
Sec. 18 - 22S - 9W
Reno County, Kansas
Farm: Wisby # 2
Well Owner: White & Ellis
Contractor: White & Ellis Drilling, Inc.
Started: 5-24-57
Completed: 6-5-57

Kelly Bushing Measurements 5 feet above ground level.

<u>FORMATION</u>	<u>DEPTH</u>
Sand	0- 110
Shale	239
Red rock	790
Shale gray & black	1291
Shale	1330
Lime	1790
Lime & shale	1910
Lime	2010
Lime & shale	2100
Shale	2195
Lime & shale	2220
Shale, green & gray	2235
Shale	2545
Lime	2600
Shale	2665
Lime & shale	2928
Lime sandy	2942
Shale & lime	2970
Shale	3025
Top of Lansing	
Lime	3325
Base of Kansas City	
Lime & shale	3373
Lime, gray & white	3397
Lime	3448
Lime & red chert	3485
Lime & shale	3521
Top of Viola	
Lime	3614
Top of Simpson	
Shale	3620
Sand	3632½
Dry hole, plug and abandon	

PLUGGING

FILE SEC. 18 T. 22 R. 9W
BOOK PAGE 19 LINE 22

RECEIVED
STATE CORPORATION COMMISSION

AUG 8 1957

CONSERVATION DIVISION
Wichita, Kansas