


STATE OF KANSAS  
STATE CORPORATION COMMISSION

WELL PLUGGING RECORD

Give All Information Completely  
Make Required Affidavit  
Mail or Deliver Report to:  
Conservation Division  
State Corporation Commission  
212 No. Market  
Wichita, Kansas

Reno County. Sec. 18 Twp. 22 Rge. (E) 9 (W)

Location as "NE/CNW/SW" or footage from lines NE NE NE  
Lease Owner McAdams Pipe & Supply Company  
Lease Name Wisby Well No. 1  
Office Address P.O. Drawer 960, Bristow, Oklahoma  
Character of Well (completed as Oil, Gas or Dry Hole) dry hole  
Date well completed \_\_\_\_\_ 19\_\_\_\_  
Application for plugging filed September 22 19 67  
Application for plugging approved \_\_\_\_\_ 19\_\_\_\_  
Plugging commenced October 18 19 67  
Plugging completed October 27 19 67  
Reason for abandonment of well or producing formation dry

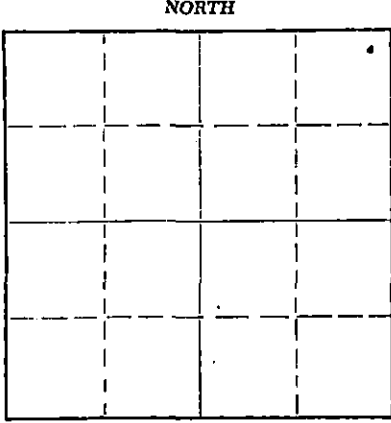

Locate well correctly on above  
Section Plat

If a producing well is abandoned, date of last production \_\_\_\_\_ 19\_\_\_\_  
Was permission obtained from the Conservation Division or its agents before plugging was commenced? yes

Name of Conservation Agent who supervised plugging of this well Gilbert Toman  
Producing formation \_\_\_\_\_ Depth to top \_\_\_\_\_ Bottom \_\_\_\_\_ Total Depth of Well 3725 Feet  
Show depth and thickness of all water, oil and gas formations.

OIL, GAS OR WATER RECORDS

CASING RECORD


| FORMATION | CONTENT | FROM | TO    | SIZE   | PUT IN | PULLED OUT |
|-----------|---------|------|-------|--------|--------|------------|
|           |         | 0    | 256'  | 10"    | 256'   | none       |
|           |         | 0    | 3659' | 5 1/2" | 3659'  | 1732.34    |
|           |         |      |       |        |        |            |
|           |         |      |       |        |        |            |
|           |         |      |       |        |        |            |
|           |         |      |       |        |        |            |

Describe in detail the manner in which the well was plugged, indicating where the mud fluid was placed and the method or methods used in introducing it into the hole. If cement or other plugs were used, state the character of same and depth placed, from \_\_\_\_\_ feet to \_\_\_\_\_ feet for each plug set.

Pushed plug to 3600' and dumped 15 gallons of egg rock. Mixed and dumped 7 sacks of cement.

Pushed plug to 245', set 15' rock bridge and dumped 5 sacks of cement for over night plug. Bailed hole down to 230' and dumped 20 sacks of cement. Filled hole with mud to 40', set 10' rock bridge and capped hole with 10 sacks of cement.

12-13-67

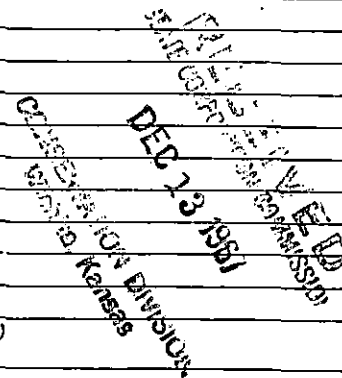

(If additional description is necessary, use BACK of this sheet)  
Name of Plugging Contractor Pipe Pullers, Inc.  
Address Box 486, Ellinwood, Kansas

STATE OF Kansas, COUNTY OF Barton, ss.  
Dean Wells (employee of owner) or (owner or operator) of the above-described well, being first duly sworn on oath, says: That I have knowledge of the facts, statements, and matters herein contained and the log of the above-described well as filed and that the same are true and correct. So help me God.

(Signature) Dean Wells  
Ellinwood, Kansas  
(Address)

SUBSCRIBED AND SWORN to before me this 8th day of November, 19 67

My commission expires July 7, 1968  
[Signature] Notary Public.


WELL LOG BUREAU - KANSAS GEOLOGICAL SOCIETY.  
412 Union National Bank Bldg, Wichita, Kansas.

W.H. BRIM  
E. Wisby No. 1

SEC. 18 T. 22 R. 9 W.  
NE 1/4 NE  
330' FNL 530' FEL NE 1/4

Total Depth. 3725  
Comm. 6-25-42 Comp. 7-6-42  
Shot or Treated.  
Contractor.  
Issued. 8-8-42

County Reno.

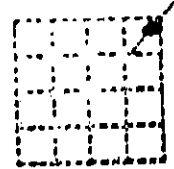

CASING.

10" 256'

Elevation.

Production. DRY.

Figures Indicate Bottom of Formations.

|                          |         |
|--------------------------|---------|
| surface                  | 60      |
| red rock sandy           | 319     |
| sand                     | 390     |
| shale and shells         | 1005    |
| sand                     | 1045    |
| shale and salt           | 1140    |
| shale                    | 1220    |
| anhydrite                | 1260    |
| lime and shale           | 1335    |
| broken lime              | 1420    |
| shale                    | 1440    |
| shells                   | 1465    |
| lime                     | 1490    |
| lime and shale           | 1530    |
| lime, shale and shells   | 1645    |
| broken lime              | 1720    |
| lime                     | 1745    |
| broken lime              | 1800    |
| lime and shale           | 2282    |
| lime                     | 2309    |
| shale                    | 2340    |
| shale and lime           | 2496    |
| lime                     | 2550    |
| lime and shale           | 2615    |
| lime                     | 2640    |
| lime and shale           | 2675    |
| lime                     | 2680    |
| lime                     | 2910    |
| lime and shale           | 2985    |
| shale                    | 3095    |
| lime and shale           | 3140    |
| lime                     | 3422    |
| lime and shale           | 3440    |
| shale and chert          | 3448    |
| shale and lime           | 3463    |
| shale                    | 3490    |
| shale and lime           | 3531    |
| lime                     | 3562    |
| Core No. 1 Rec 3'        | 3562-68 |
| lime & chert, with shale |         |
| partings, no shows.      |         |
| lime                     | 3578    |
| cherty                   | 3593    |
| lime                     | 3614    |
| sand                     | 3619    |
| shale                    | 3675    |
| dolomite                 | 3677    |
| Core No. 2 Rec. 4'       | 3677-83 |
| Dolomite - no shows.     |         |
| chert & dolomite         | 3696    |
| dolomite                 | 3725    |
| Total Depth.             |         |

|                  |      |
|------------------|------|
| TOPS - Topeka    | 2630 |
| Lans. Kans. City | 3115 |
| Conglomerate     | 3422 |
| Kinderhook       | 3426 |
| Viola            | 3516 |
| Simpson          | 3615 |
| Arbuckle         | 3675 |

RECEIVED  
KANSAS CORPORATION COMMISSION  
SEP 25 1967  
CONSERVATION DIVISION  
Wichita, Kansas