


STATE OF KANSAS
STATE CORPORATION COMMISSION

Form CP-4

Give All Information Completely
Make Required Affidavit
Mail or Deliver Report to:
Conservation Division
State Corporation Commission
P. O. Box 17027
Wichita, Kansas 67217
NORTH

WELL PLUGGING RECORD

Reno County, Sec. 18 Twp. 22 Rge. 9 (E) 9 (W)
Location as "NE/CNW/SE" or footage from lines SE NW SE
Lease Owner McAdams Pipe & Supply Company
Lease Name Homer Drake "B" Well No. 2
Office Address P.O. Drawer 960, Bristow, Oklahoma 74010
Character of Well (completed as Oil, Gas or Dry Hole) oil
Date well completed 19
Application for plugging filed March 22 19 73
Application for plugging approved 19
Plugging commenced April 6 19 73
Plugging completed April 28 19 73
Reason for abandonment of well or producing formation depleted

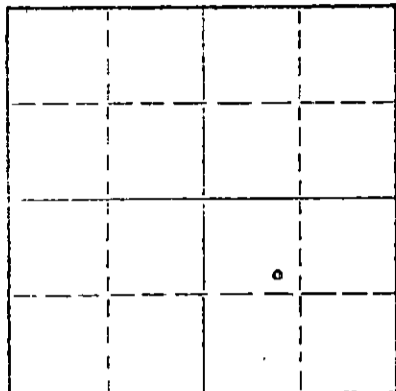

Locate well correctly on above Section Plat

If a producing well is abandoned, date of last production 19
Was permission obtained from the Conservation Division or its agents before plugging was commenced? Yes

Name of Conservation Agent who supervised plugging of this well Gilbert Toman
Producing formation Depth to top Bottom Total Depth of Well 3683 Feet
Show depth and thickness of all water, oil and gas formations.

OIL, GAS OR WATER RECORDS

CASING RECORD

FORMATION	CONTENT	FROM	TO	SIZE	PUT IN	PULLED OUT
		0	220'	8 5/8"	220'	none
			3681'	5 1/2"	3681'	2279.67

Describe in detail the manner in which the well was plugged, indicating where the mud fluid was placed and the method or methods used in introducing it into the hole. If cement or other plugs were used, state the character of same and depth placed, from feet to feet for each plug set.

Sanded back to 3600' and dumped 5 sacks of cement.
Plugged well with 4 sacks of hulls, 20 sacks of mud and 100 sacks of cement.

RECEIVED
STATE CORPORATION COMMISSION
MAY 3 1973
CONSERVATION DIVISION
Wichita, Kansas

(If additional description is necessary, use BACK of this sheet)
Name of Plugging Contractor PIPE PULLERS, INC.
Address Box 486, Ellinwood, Kansas

STATE OF KANSAS COUNTY OF BARTON, ss.
Evelyn Roth (employee of owner) or (owner or operator) of the above-described well, being first duly sworn on oath, says: That I have knowledge of the facts, statements, and matters herein contained and the log of the above-described well as filed and that the same are true and correct. So help me God.

(Signature) Evelyn Roth
Ellinwood, Kansas
(Address)

SUBSCRIBED AND SWORN TO before me this 30th day of April 1973

My commission expires Feb. 10, 1975
Serge A Meyer Notary Public.

WELL LOG BUREAU—KANSAS GEOLOGICAL SOCIETY
508 East Murdock, Wichita, Kansas

15-155-01656-0000


COPY

Company- GLOBE OIL & REFINING CO.
Farm- Homer Drake "B" No. 2

SEC. 18 T. 22 R. 9W
SE NW SE

Total Depth. 3683'
Comm. 2-5-59 Comp. 2-16-59
Shot or Treated.
Contractor. Group Exploration
Issued. 6-6-59

County Reno
KANSAS

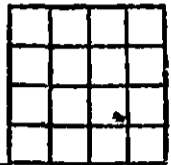

Elevation. 1744' RB

Production. 232 BOPD, 32% Wtr.

CASING:

8 5/8" 220.46' cem w/200 sx.
5 1/2" 3681' cem w/100 sx.

Figures Indicate Bottom of Formations.

surface	220
red bed	355
Anhydrite	375
shale & shells .	1250
shale & lime	1690
lime	1805
shale	2520
shale & lime	2595
lime	2850
lime & shale	3105
lime	3420
shale & lime	3577
lime	3628
Coring (Simpson)	3667
shale	3683 RTD
Total Depth	

TOPS: R.B. MEAS.

Anhydrite (scout)	355
Heebner	2933
Brown Lime	3080
Lansing	3105
Conglomerate	3440
Kinderhook	3453
Maquoketa	3500
Viola	3526
Simpson Shale	3627
Simpson Sand	3632
Base 1st Simpson Sand	3648
Second Simpson Sand	3660
Base 2nd Simpson Sand	3672

2-19-59 Welex perforated 26 bullets
and 26 super dyna jets
3635-3648'.

2-19-59 Halliburton acidized w/500 gala.
MCA.

2-20-59 Halliburton fraced w/15,000# sand
10,000 gala. jel-kerosene.

RECEIVED
STATE CORPORATION COMMISSION
MAR 23 1973
CONSERVATION DIVISION
Wichita, Kansas