


STATE OF KANSAS  
STATE CORPORATION COMMISSION

WELL PLUGGING RECORD

Give All Information Completely  
Make Required Affidavit  
Mail or Deliver Report to:  
Conservation Division  
State Corporation Commission  
212 No. Market  
Wichita, Kansas

NORTH

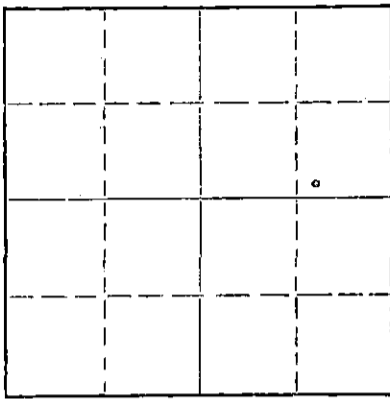

Locate well correctly on above  
Section Plat

Reno County, Sec. 18 Twp. 22 Rge. (E) 9 (W)

Location as "NE/CNW/SW" or footage from lines SW SE NE  
Lease Owner McAdams Pipe & Supply Company  
Lease Name Wisby Well No. 3  
Office Address P.O. Drawer 960, Bristow, Oklahoma  
Character of Well (completed as Oil, Gas or Dry Hole) oil  
Date well completed 19  
Application for plugging filed September 22 19 67  
Application for plugging approved 19  
Plugging commenced October 28 19 67  
Plugging completed November 14 19 67  
Reason for abandonment of well or producing formation depleted

If a producing well is abandoned, date of last production 19  
Was permission obtained from the Conservation Division or its agents before plugging was commenced? YES

Name of Conservation Agent who supervised plugging of this well Gilbert Toman  
Producing formation Depth to top Bottom Total Depth of Well 3676 Feet  
Show depth and thickness of all water, oil and gas formations.

OIL, GAS OR WATER RECORDS

CASING RECORD

FORMATION	CONTENT	FROM	TO	SIZE	PUT IN	PULLED OUT
		0	223'	8 5/8"	223'	none
		0	3675'	4 1/2"	3675'	1581.70

Describe in detail the manner in which the well was plugged, indicating where the mud fluid was placed and the method or methods used in introducing it into the hole. If cement or other plugs were used, state the character of same and depth placed, from feet to feet for each plug set.

Squeezed off 4 1/2" oil string with 15 sacks of gel mud and 25 sacks of bulk cement.  
Squeezed off 8 5/8" oil string with 10 sacks of gel mud and 75 sacks of bulk cement.

RECEIVED  
STATE CORPORATION COMMISSION  
DEC 13 1967

CONSERVATION DIVISION  
KANSAS  
12-13-67

Name of Plugging Contractor Pipe Pullers, Inc.  
Address Box 486, Ellinwood, Kansas

STATE OF Kansas, COUNTY OF Barton, ss.  
Dean Wells (employee of owner) or (owner or operator) of the above-described well, being first duly sworn on oath, says: That I have knowledge of the facts, statements, and matters herein contained and the log of the above-described well as filed and that the same are true and correct. So help me God.

(Signature) Dean Wells  
Ellinwood, Kansas

SUBSCRIBED AND SWORN TO before me this 16th day of November, 19 67

My commission expires July 7, 1968 Notary Public.


WELL LOG BUREAU—KANSAS GEOLOGICAL SOCIETY  
508 East Murdock, Wichita, Kansas

Company. CHARLES RITCHIE  
Farm. Wisby No. 3

SEC. 18 T. 22 R. 9W  
SW SE NE

Total Depth. 3676'  
Comm. 2-18-59 Comp. 2-28-59  
Shot or Treated.  
Contractor, White & Ellis Drlg.  
Issued. 6-17-61

County Reno  
KANSAS

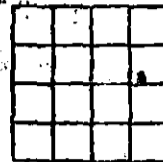

CASING:  
8 5/8" 223' cem w/200 sx  
4 1/2" 3675' cem w/100 sx

Elevation. 1742' RB

Production. 154 BOPD

Figures Indicate Bottom of Formations.

sand	110
sandy shale	185
red rock	200
shale	310
red rock	345
lime & shale	360
shale & red rock	660
shale & shells	1235
lime & shale	1470
shale & red rock	1500
lime & shale	1700
lime & shale streaks	1860
shale & lime	1920
lime w/shale streaks	2115
shale & shells	2270
shale w/lime streaks	2475
shale	2530
lime w/shale streaks	2585
lime	2595
sandy shale	2641
lime	2800
lime w/shale streaks	2860
shale & lime	2936
sand & shale	3035
sandy shale	3080
lime & shale sandy	3108
lime Lansing K.C.	3157
lime	3450
shale & lime	3528
lime Viola	3629
sand, Simpson	3644
sand & shale	3676
Total Depth	

TOPS: SCOUT	
Heabner	2936
Lansing	3106
Conglomerate	3442
Kinderhook	3454
Maquoketa	3502
Viola	3528
Simpson Sand	3629