


STATE OF KANSAS  
STATE CORPORATION COMMISSION

Give All Information Completely  
Make Required Affidavit  
Mail or Deliver Report to:  
Conservation Division  
State Corporation Commission  
800 Bittling Building  
Wichita, Kansas

WELL PLUGGING RECORD

NORTH

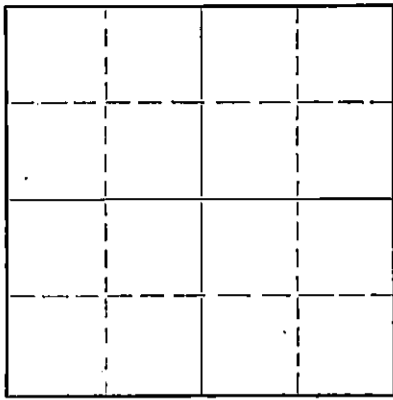

Locate well correctly on above  
Section Plat

Stafford County. Sec. 24 Twp. 22 Rge. 14 (E) (W)  
Location as "NE/CNW/SW" or footage from lines NW SW SW  
Lease Owner Anschutz Drilling Company, Inc.  
Lease Name Smith Well No. 2  
Office Address Union Nat'l Bk Bldg., Wichita, Kansas  
Character of Well (completed as Oil, Gas or Dry Hole) Oil  
Date well completed 4-8 1950  
Application for plugging filed 9-3 1952  
Application for plugging approved 9-4 1952  
Plugging commenced 9-4 1952  
Plugging completed 9-10 1952  
Reason for abandonment of well or producing formation Production exhausted

If a producing well is abandoned, date of last production August 19, 1952  
Was permission obtained from the Conservation Division or its agents before plugging was commenced? Yes

Name of Conservation Agent who supervised plugging of this well M. A. Rives  
Producing formation Lansing-KC Depth to top 3628 Bottom 3718 Total Depth of Well 3825 Feet  
Show depth and thickness of all water, oil and gas formations.

OIL, GAS OR WATER RECORDS

CASING RECORD

FORMATION	CONTENT	FROM	TO	SIZE	PUT IN	PULLED OUT
				8-5/8"	333'	
				5-1/2"	3754'	2885'

Describe in detail the manner in which the well was plugged, indicating where the mud fluid was placed and the method or methods used in introducing it into the hole. If cement or other plugs were used, state the character of same and depth placed, from \_\_\_\_\_ feet to \_\_\_\_\_ feet for each plug set.

Filled hole with sand to 3500' and cement 3464' - 5 sacks  
Filled hole with mud to 320' and rock to 300'  
Ran 20 sacks cement from 300' to 260'  
Filled with mud to 35' and cap with 10 sacks cement

(If additional description is necessary, use BACK of this sheet)

Name of Plugging Contractor Morgan Well Plugging Service  
Address Hutchinson, Kansas

STATE OF KANSAS, COUNTY OF SEDGWICK, ss.  
E. B. Snell (employee of owner) or (owner or operator) of the above-described well, being first duly sworn on oath, says: That I have knowledge of the facts, statements, and matters herein contained and the log of the above-described well as filed and that the same are true and correct. So help me God.

(Signature) E. B. Snell  
709 Union Nat'l Bk Bldg., Wichita, Ks.  
(Address)

SUBSCRIBED AND SWORN TO before me this 14th day of November, 19 52

My commission expires May 2, 1956  
Jacqueline Korman Notary Public.

24-2875-B  
**PLUGGING**  
FILE SEC 24 T 22 R 142  
BOOK PAGE 42 LINE 15

2-52-20M  
RECEIVED  
NOV 18 1952  
CONSERVATION DIVISION  
Wichita, Kansas

DRILLER'S LOG

Anschutz Drilling Company, Inc.  
 #2 Smith  
 NW SW SW - 24-22S-14W  
 Stafford County, Kansas

<u>FROM</u>	<u>TO</u>	
0	180	Sand
180	350	Shale & shells
350	670	Red bed & shells
670	810	Red bed
810	840	Anhydrite
840	1640	Shale & shells
1640	1875	Shale & lime
1875	2100	Lime & shale
2100	2330	Lime
2330	2895	Shale & lime
2895	3175	Lime & shale
3175	3215	Lime
3215	3340	Shale & lime
3340	3811	Lime
3811	3815	Shale
3815	3825	Arbuckle lime
	3825	TOTAL DEPTH

COMMENCED: 3-26-50  
 COMPLETED: 4-8-50

CASING RECORD:

Set 8-5/8" surface casing at 333 feet with 200 sacks cement.  
 Set 5-1/2" casing at 3754 feet with 150 sacks cement.

STATE OF KANSAS )  
 ) SS  
 COUNTY OF SEDGWICK )

I hereby affirm that the above and foregoing is a true and correct copy of the log of the #2 Smith well, located NW SW SW of Section 24-22S-14W, Stafford County, Kansas.

ANSCHUTZ DRILLING COMPANY, INC.


BY:

*Leon L. Mehler*  
 Leon L. Mehler

Subscribed and sworn to before me this 17th day of November, 1952.

*Jaqueline K. Korman*  
 Notary Public

My Commission Expires: May 2, 1956

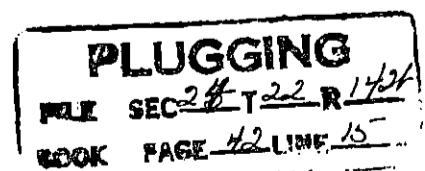

CONCESSIONS SECTION  
 Wichita, Kansas