


STATE OF KANSAS  
STATE CORPORATION COMMISSION

WELL PLUGGING RECORD

Give All Information Completely  
Make Required Affidavit  
Mail or Deliver Report to:  
Conservation Division  
State Corporation Commission  
800 Biting Building  
Wichita, Kansas

NORTH

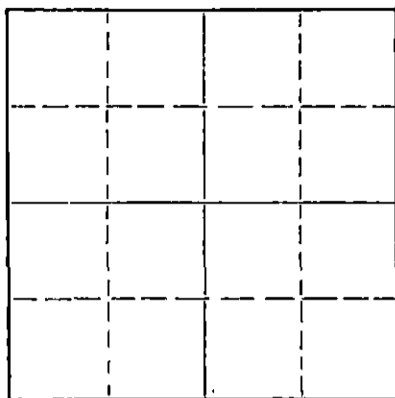

Locate well correctly on above  
Section Plat

STAFFORD County, Sec. 24 Twp. 22 Rge. 14 (E) W (W)  
Location as "NE/CNW/SW" or footage from lines Gen. SW NW NW  
Lease Owner: Cities Service Oil Company  
Lease Name: Eggebrecht Well No. 4  
Office Address: Great Bend, Kansas  
Character of Well (completed as Oil, Gas or Dry Hole) Dry Hole  
Date well completed May 30 19 56  
Application for plugging filed May 30 19 56  
Application for plugging approved May 30 19 56  
Plugging commenced May 30 19 56  
Plugging completed May 30 19 56  
Reason for abandonment of well or producing formation Dry Hole

If a producing well is abandoned, date of last production 19\_\_\_\_  
Was permission obtained from the Conservation Division or its agents before plugging was commenced? Yes

Name of Conservation Agent who supervised plugging of this well R. M. Brundege  
Producing formation Arbuckle Depth to top 3814 Bottom 3845 Total Depth of Well 3845 Feet  
Show depth and thickness of all water, oil and gas formations.

OIL, GAS OR WATER RECORDS

CASING RECORD

FORMATION	CONTENT	FROM	TO	SIZE	PUT IN	PULLED OUT
				8-5/8"	436'	None

Describe in detail the manner in which the well was plugged, indicating where the mud fluid was placed and the method or methods used in introducing it into the hole. If cement or other plugs were used, state the character of same and depth placed, from \_\_\_\_\_ feet to \_\_\_\_\_ feet for each plug set.

3845-210', mud  
210-140', wood plug, hulls and 20 sacks cement  
140- 35', mud.  
35' to base of cellar, wood plug, hulls and 10 sacks cement.

(If additional description is necessary, use BACK of this sheet)

Name of Plugging Contractor: Prime Drilling Company  
Address: Wichita, Kansas

STATE OF Kansas, COUNTY OF Barton, ss.  
F. T. Jones (employee of owner) or (owner or operator) of the above-described well, being first duly sworn on oath, says: That I have knowledge of the facts, statements, and matters herein contained and the log of the above-described well as filed and that the same are true and correct. So help me God.

(Signature) F.T. Jones  
Box 751, Great Bend, Kansas  
(Address)

SUBSCRIBED AND SWORN TO before me this 5th day of June, 19 56

Betty J. Sloan  
Notary Public.

My commission expires April 24, 1957

PLUGGING  
FILE SEC. 24 T. 22 R. 146  
BOOK PAGE 66 LINE 42

CONSERVATION DIVISION  
WICHITA, KANSAS

6-6-56

# WELL RECORD

Company Cities Service Oil Co. Well No. 4 Farm 24 22 14W  
 Location 990' South and 390' East of NW Corner Sec. 24 T. 22 R. 14W  
 Elevation 1927 (1925 Gr.) County Stafford State Kansas  
 Drlg. Comm. May 18, 1956 Contractor Prime Drilling Company  
 Drlg. Comp. May 30, 1956 Acid None  
 T. D. 3845' Initial Prod. None - Dry Hole (P. & A. 5-30-56)

CASING RECORD:

3-5/8" @ 436' cas. with 300 int cement

FORMATION RECORD:

sand	0-215
shale	390
red bed	610
anhydrite	835
shale & shale	1335
salt & shale	1635
shale & lime	1725
lime & shale	2200
shale & lime	2955
lime & shale	3005
lime	3670
lime & shale	3730
cherty lime & shale	3764
lime & chert	3820
lime & dolomite	3845 T. D.

Topoka	2982'
Hebner	3303'
Broom Limestone	3486'
Lansing	3448'
Cherty Conglomerate	3730'
Viola	3737'
Simpson	3774'
Arbuckle	3814'
Penetration	31'
Total Depth	3845'

Drill stem test 3596-3616, open 1 hr., recovered 100' slightly oil and gas-cut mud and 63' muddy salt water; D. H. P. 690#/30 mins.

Drill stem test 3625-36, open 1 hr., recovered 10' mud; D. H. P. 0#/30 mins.

Drill stem test 3739-64, open 1 hr., recovered 20' mud with few spots oil; D. H. P. 0#/30 mins.

SLOPE TESTS (SURE SHOT):

385'	3/4°
700'	1°
1000'	3/4°
1500'	1/4°
2000'	1/2°
2500'	3/4°
3000'	1/4°
3500'	1/2°

RECEIVED  
 STATE CORPORATION COMMISSION  
 JUN 6 X 1956  
 CONSERVATION DIVISION  
 Topeka, Kansas

PLUGGING  
 FILE SEC. 24 T. 22 R. 14W  
 BOOK PAGE 66 LINE 42