

TYPE

AFFIDAVIT OF COMPLETION FORM

ACO-1 WELL HISTORY

SIDE ONE

Two (2) copies of this form shall be filed with the Kansas Corporation Commission, 200 Colorado Derby Building, Wichita, Kansas 67202, within thirty (30) days after the completion of a well, regardless of how the well was completed.

Attach separate letter of request if the information is to be held confidential. If confidential, only file one copy. Information on Side One will be of public record and Side Two will then be held confidential.


Applications must be made on dual completion, commingling, salt water disposal, injection and temporarily abandoned wells.

Attach one copy only wireline logs (i.e. electrical log, sonic log, gamma ray neutron log, etc.). (Rules 82-2-105 & 82-2-125) KCC# (316) 263-3238.

LICENSE # 5430 EXPIRATION DATE JUNE 30, 1983  
 OPERATOR ENERGY THREE, INC. API NO. 15-185-21,782-0000  
 ADDRESS P. O. Box 1505 COUNTY STAFFORD  
GREAT BEND, KANSAS 67530 FIELD \_\_\_\_\_  
 \*\* CONTACT PERSON R. D. STANDLEE PROD. FORMATION \_\_\_\_\_  
PHONE AC 316-792-5968  
 PURCHASER KXX LEASE SPANGENBERG  
 ADDRESS XXXXXXXXXXXXXXXXXX WELL NO. 3  
 DRILLING BIG THREE DRILLING, INC. WELL LOCATION C S/2 NW SE  
 CONTRACTOR P. O. Box 52 660 Ft. from WEST Line and  
 ADDRESS GORHAM, KANSAS 67640 990 Ft. from NORTH Line of  
 the SE (Qtr.) SEC 21 TWP 22 S RGE 12 W.

PLUGGING ALLIED CEMENTING  
 CONTRACTOR \_\_\_\_\_  
 ADDRESS RUSSELL, KANSAS 67665

TOTAL DEPTH 3705 PBD \_\_\_\_\_  
 SPUD DATE 4-20-83 DATE COMPLETED 4-29-83  
 ELEV: GR 1864 DF \_\_\_\_\_ KB 1869  
 DRILLED WITH (CABLE) (ROTARY) (AIR) TOOLS.  
 DOCKET NO. OF DISPOSAL OR REPRESSURING WELL BEING  
 USED TO DISPOSE OF WATER FROM THIS LEASE N/A

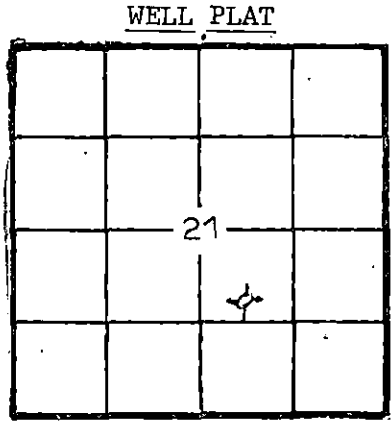

(Office Use Only)  
 KCC   
 KGS   
 SWD/REP \_\_\_\_\_  
 PLG.

Amount of surface pipe set and cemented 250 DV Tool Used? NO

THIS AFFIDAVIT APPLIES TO: (Circle ONE) - Oil, Gas, Shut-in Gas, (Dry), Disposal, Injection, Temporarily Abandoned, OWWO. Other \_\_\_\_\_

ALL REQUIREMENTS OF THE STATUTES, RULES AND REGULATIONS PROMULGATED TO REGULATE THE OIL AND GAS INDUSTRY HAVE BEEN FULLY COMPLIED WITH.


A F F I D A V I T

R. D. STANDLEE, being of lawful age, hereby certifies that:

I am the Affiant, and I am familiar with the contents of the foregoing Affidavit. The statements and allegations contained therein are true and correct.

R. D. Standlee  
 (Name)

SUBSCRIBED AND SWORN TO BEFORE ME this 20TH day of MAY, 1983.

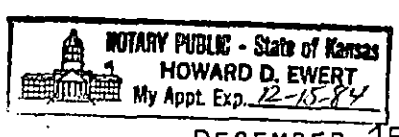

Howard D. Ewert  
 (NOTARY PUBLIC)

MY COMMISSION EXPIRES: DECEMBER 15, 1984

RECEIVED  
 CORPORATION COMMISSION  
 MAY 24 1983  
 CONSERVATION DIVISION  
 Wichita, Kansas

\*\* The person who can be reached by phone regarding any questions concerning this information.

SIDE TWO

ACO-1 WELL HISTORY

OPERATOR ENERGY THREE, INC. LEASE SPANGENBERG SEC. 21 TWP 22S RGE. 12W

**FILL IN WELL LOG AS REQUIRED:**

Show all important zones of porosity and contents thereof; cored intervals, and all drill-stem tests, including depth interval tested, cushion used, time tool open, flowing and shut-in pressures, and recoveries.

SHOW GEOLOGICAL MARKERS, LOGS RUN, OR OTHER DESCRIPTIVE INFORMATION.

FORMATION DESCRIPTION, CONTENTS, ETC.	TOP	BOTTOM	NAME	DEPTH
SAND	-0-	250	NO ELECTRIC LOGS RUN	
SHALE & SAND	250	637		
ANHYDRITE	637	672		
SAND & SHALE	672	1925		
SHALE	1925	2195		
LIME & SHALE	2195	3705 R.T.D.		

**Report of all strings set — surface, intermediate, production, etc. CASING RECORD (New) or (Used)**

Purpose of string	Size hole drilled	Size casing set (in O.D.)	Weight lbs/ft.	Setting depth	Type cement	Sacks	Type and percent additives
SURFACE	12 1/4	8 5/8	20#	250	50/50 P03	225	3% C.C. 2% GEL.

**LINER RECORD**

**PERFORATION RECORD**

Top, ft.	Bottom, ft.	Sacks cement	Shots per ft.	Size & type	Depth interval

**TUBING RECORD**

Size	Setting depth	Packer set at

**ACID, FRACTURE; SHOT, CEMENT SQUEEZE RECORD**

Amount and kind of material used	Depth interval treated

Date of first production	Producing method (flowing, pumping, gas lift, etc.)	Gravity
DRY/HOLE		

DATE OF PRODUCTION PER 24 HOURS	Oil	Gas	Water	Gas-oil ratio
	bbbls.	MCF	%	bbbls. CFPB

Disposition of gas (vented, used on lease or sold)	Perforations