

CARD MUST BE TYPED

State of Kansas
NOTICE OF INTENTION TO DRILL
(see rules on reverse side)

15-083-21200-0000

CARD MUST BE SIGNED

Starting Date: 7 6 85
month day year

OPERATOR: License # 5011
Name Viking Resources
Address 217 E. William
City/State/Zip Wichita, KS 67202-4005
Contact Person Jim Devlin
Phone 316-262-2502

CONTRACTOR: License # 5420
Name White and Ellis Drilling
City/State Wichita, Kansas

Well Drilled For: Well Class: Type Equipment:
 Oil Swd Infield Mud Rotary
 Gas Inj Pool Ext. Air Rotary
 OWWO Expl Wildcat Cable

If OWWO: old well info as follows:

Operator
Well Name
Comp Date Old Total Depth
Projected Total Depth 4400 feet
Projected Formation at TD Mississippian
Expected Producing Formations Mississippian

API Number 15- 083-21,200
100' E of East
NW.NW.NE... Sec .26. Twp .22 S, Rge .22. West
(location)

4950 Ft North from Southeast Corner of Section
2210 Ft West from Southeast Corner of Section
(Note: Locate well on Section Plat on reverse side)

Nearest lease or unit boundary line 330 feet.
County Hodgeman
Lease Name Hann Well# 2

Domestic well within 330 feet: yes no
Municipal well within one mile: yes no

Depth to Bottom of fresh water 150 feet
Lowest usable water formation Dakota
Depth to Bottom of usable water 275 feet
Surface pipe by Alternate: 1 2
Surface pipe to be set 275 feet
Conductor pipe if any required None feet
Ground surface elevation Est. 2150 - Unknown in HC feet MSL
This Authorization Expires 12-20-85
Approved By 6-20-85 [Signature]

I certify that we will comply with K.S.A. 55-101, et seq., plus eventually plugging hole to K.C.C. specifications.


Date 19 June 1985 Signature of Operator or Agent James B. Devlin Title

WMC/MOHE 6/20/85
Operator

Must be filed with the K.C.C. five (5) days prior to commencing well
This card void if drilling not started within six (6) months of date received by K.C.C.

Important procedures to follow:

**A Regular Section of Land
1 Mile = 5,280 Ft.**

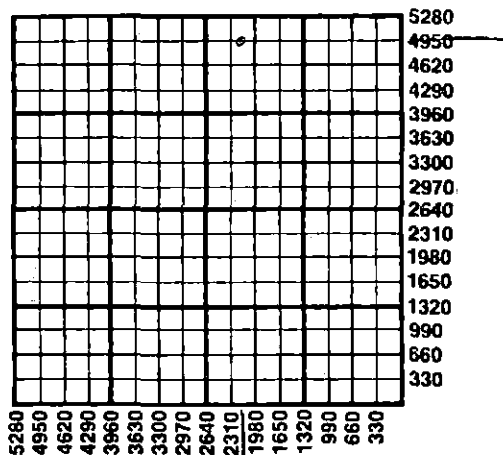

1. Notify District office before setting surface casing.
2. Set surface casing by circulating cement to the top.
3. File completion forms ACO-1 with K.C.C. within 90 days of well completion, following instructions on ACO-1, side 1, and including copies of wireline logs.
4. Notify District office 48 hours prior to old well workover or re-entry.
5. Prior to plugging, prepare a plugging plan, then obtain agreement from the appropriate district office for an approved plugging plan.
6. Submit plugging report (CP-4) to K.C.C. after plugging is completed.
7. Obtain an approved injection docket number before disposing of salt water.
8. Notify K.C.C. within 10 days when injection commences or terminates.
9. If an alternate completion, cement in the production pipe from below any usable water to surface within 120 days of spud date.

RECEIVED
STATE CORPORATION COMMISSION

State Corporation Commission of Kansas

JUN 20 1985

Conservation Division

200 Colorado Derby Building

Wichita, Kansas 67202

(316) 263-3238

CONSERVATION DIVISION
Wichita, Kansas

6-20-85