

EFFECTIVE DATE: 10-27-92

DISTRICT 3  
SEA? Yes No

State of Kansas  
NOTICE OF INTENTION TO DRILL

FORM MUST BE TYPED  
FORM MUST BE SIGNED  
ALL BLANKS MUST BE FILLED

Must be approved by the K.C.C. five (5) days prior to commencing well

Expected Spud Date October 28, 1992  
month day year

Spot  
N 1/4 NW 1/4 NW 1/4 Sec 22 Twp. 15 S. Rg 22 East

OPERATOR: License # 4441  
Name: Reusch Well Services Inc.  
Address: 401 S. Main #11  
City/State/Zip: Ottawa, Ks. 66067  
Contact Person: Bob Reusch  
Phone: Office 242-5733 / Home 242-7746

255 feet from North line of Section  
175 feet from West line of Section  
IS SECTION XXX REGULAR IRREGULAR

(NOTE: Locate well on the Section Plat on Reverse Side)

CONTRACTOR: License #: 4441  
Name: Company Tools

County: Miami  
Lease Name: C. Peer Well #: 2  
Field Name: Paola-Radon

Is this a Prorated/Spaced Field? yes XXX no  
Target Formation(s): Bartlesville

Well Drilled For: Well Class: Type Equipment:  
XX Oil ... Enh Rec ... Infield ... Mud Rotary  
XX Gas ... Storage ... Pool Ext. XX Air Rotary  
... OWHO ... Disposal ... Wildcat ... Cable  
... Solamic; ... # of Holes ... Other  
... Other

Nearest lease or unit boundary: 175'  
Ground Surface Elevation: 980 feet MSL

Water well within one-quarter mile: XX yes ... no  
Public water supply well within one mile: ... yes XXX no

If OWHO: old well information as follows:  
Operator: Unknown  
Well Name: ? may be "Moll Brothers"  
Comp. Date: circa 1965 Old Total Depth: 375'

Depth to bottom of fresh water: 197'  
Depth to bottom of usable water: 197'

Surface Pipe by Alternate: 1 2  
Length of Surface Pipe Planned to be set: 20'

Length of Conductor pipe required:  
Projected Total Depth: 860'

Formation at Total Depth: Bartlesville  
Water Source for Drilling Operations:

Directional, Deviated or Horizontal wellbore? ... yes XX no  
If yes, true vertical depth:  
Bottom Hole Location:

... well XX farm pond ... other  
DWR Permit #:  
Will Cores Be Taken? ... yes XXX no

If yes, proposed zone:

AFFIDAVIT

The undersigned hereby affirms that the drilling, completion and eventual plugging of this well will comply with K.S.A. 55-101, et. seq.  
It is agreed that the following minimum requirements will be met:

- 1. Notify the appropriate district office prior to spudding of well;
- 2. A copy of the approved notice of intent to drill shall be posted on each drilling rig;
- 3. The minimum amount of surface pipe as specified below shall be set by circulating cement to the top; in all cases surface pipe shall be set through all unconsolidated materials plus a minimum of 20 feet into the underlying formation;
- 4. If the well is dry hole, an agreement between the operator and the district office on plug length and placement is necessary prior to plugging;
- 5. The appropriate district office will be notified before well is either plugged or production casing is cemented in;
- 6. IF AN ALTERNATE II COMPLETION, PRODUCTION PIPE SHALL BE CEMENTED FROM BELOW ANY USABLE WATER TO SURFACE WITHIN 120 DAYS OF SPUD DATE. IN ALL CASES, NOTIFY DISTRICT OFFICE PRIOR TO ANY CEMENTING.

I hereby certify that the statements made herein are true and to the best of my knowledge and belief.

Date: Signature of Operator or Agent: Title:

FOR KCC USE:  
API # 15- 12-01-026-00-00 15-21-2004-00-01  
Conductor pipe required None feet  
Minimum surface pipe required 20 feet per Alt. X (2)  
Approved by: CB. 10-22-92  
This authorization expires: 4-22-93  
(This authorization void if drilling not started within 6 months of effective date.)  
Spud date: Agent:

RECEIVED  
STATE CORPORATION COMMISSION

OCT 22 1992

CONSERVATION DIVISION  
Wichita, Kansas

REMEMBER TO:

- File Drill Pit Application (form CDP-1) with Intent to Drill;
- File Completion Form ACO-1 within 120 days of spud date;
- File acreage attribution plat according to field preparation orders;
- Notify appropriate district office 48 hours prior to workover or re-entry;
- Submit plugging report (CP-4) after plugging is completed;
- Obtain written approval before disposing or injecting salt water.

Mail to: Conservation Division, 208 Colorado Berby Building, 202 W. First St., Wichita, Kansas 67202-1286.

IN ALL CASES PLOT THE INTENDED WELL ON THE PLAT BELOW

**PLAT OF ACREAGE ATTRIBUTABLE TO A WELL IN A PRORATED OR SPACED FIELD**

If the intended well is in a prorated or spaced field, please fully complete this side of the form. If the intended well is in a prorated or spaced field complete the plat below showing that the well will be properly located in relationship to other wells producing from the common source of supply. Please show all the wells within 1 mile of the boundaries of the proposed acreage attribution unit for gas wells and within 1/2 mile of the boundaries of the proposed acreage attribution unit for oil wells.

API NO. 15- \_\_\_\_\_  
 OPERATOR \_\_\_\_\_  
 LEASE \_\_\_\_\_  
 WELL NUMBER \_\_\_\_\_  
 FIELD \_\_\_\_\_



LOCATION OF WELL: COUNTY MIAMI  
 \_\_\_\_\_ feet from \_\_\_\_\_/north line of section  
255  
 \_\_\_\_\_ feet from \_\_\_\_\_/west line of section  
175  
 SECTION 22 TWP 15 RG 22

NUMBER OF ACRES ATTRIBUTABLE TO WELL 30  
 QTR/QTR/QTR OF ACREAGE NW $\frac{1}{4}$  - NW $\frac{1}{4}$  - NW $\frac{1}{4}$

IS SECTION XXX REGULAR or \_\_\_\_\_ IRREGULAR  
IF SECTION IS IRREGULAR, LOCATE WELL FROM NEAREST CORNER BOUNDARY.

Section corner used: \_\_\_\_\_ NE XXNW \_\_\_\_\_ SE \_\_\_\_\_ SW  
PLAT

(Show location of the well and shade attributable acreage for prorated or spaced wells.)  
 (Show footage to the nearest lease or unit boundary line.)

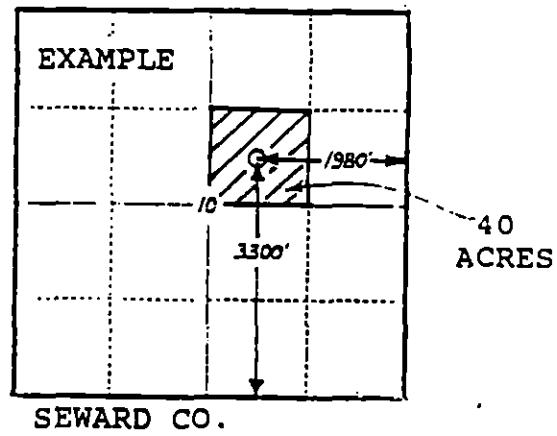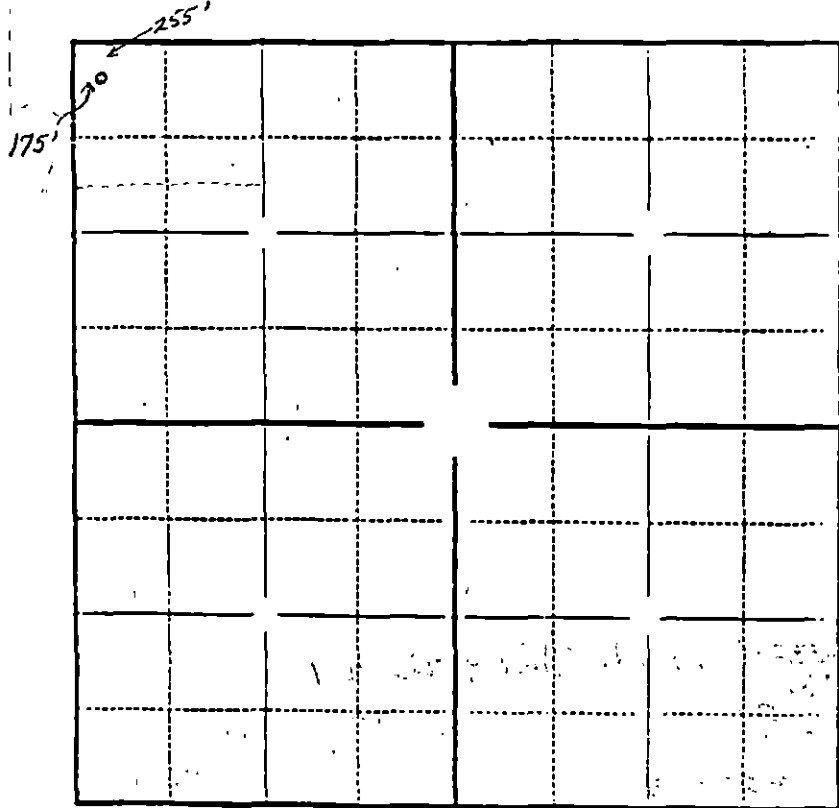

In plotting the proposed location of the well, you must show:

- 1) The manner in which you are using the depicted plat by identifying section lines, i.e. 1 section, 1 section with 8 surrounding sections, 4 sections, etc.;
- 2) the distance of the proposed drilling location from the section's south/north and east/west lines; and
- 3) the distance to the nearest lease or unit boundary line.