

CARD MUST BE TYPED

State of Kansas

CARD MUST BE SIGNED

NOTICE OF INTENTION TO DRILL

(see rules on reverse side)

Starting Date 2 14 86 month day year

API Number 15- 185-22, 137-100-01

OPERATOR: License # 4221
Name Wren Investment
Address P.O. Box 175
City/State/Zip McPherson, Kansas 67460
Contact Person Delmar Nightingale
Phone 316/654-3469

C. W/2 SW Sec. 28 Twp. 23 S, Rg. 11 West
1320 Ft. from South Line of Section
4620 Ft. from East Line of Section

(Note: Locate well on Section Plat on reverse side)

CONTRACTOR: License # 5929
Name Duke Drilling Co., Inc.
City/State Great Bend, Kansas 67530

Nearest lease or unit boundary line 330 feet
County Stafford
Lease Name Riley Well # 14-28

TOP EST 1200

Ground surface elevation feet MSL
Domestic well within 330 feet: yes X no

Well Drilled For: Well Class: Type Equipment:
Oil SWD Infield Mud Rotary
Gas Inj Pool Ext Air Rotary
X OWWO Expl Wildcat Cable

Municipal well within one mile: yes X no

Depth to bottom of fresh water 250.100

Depth to bottom of usable water 250.200

Surface pipe by Alternate: 1 X 2

If OWWO: old well info as follows:
Operator PanCanadian Petroleum Company
Well Name Riley 14-28
Comp Date 12/9/84 Old Total Depth 3850

Surface pipe phoned to be set 293

Conductor pipe required

Projected Total Depth 3850 feet

Formation Arbuckle

I certify that well will comply with K.S.A. 55-101, et seq., plus eventually plugging hole to KCC specifications.

Date 2/5/86 Signature of Operator or Agent Sally W. Byers Title Agent

REH/KHE

For KCC Use:

Conductor Pipe Required feet; Minimum Surface Pipe Required 200 feet per Alt. 1 X

This Authorization Expires 8-5-86 Approved By 2-5-86


Handwritten signature/initials

Must be filed with the K.C.C. five (5) days prior to commencing well  
This card void if drilling not started within six (6) months of date received by K.C.C.

**Important procedures to follow:**

1. Notify District office before setting surface casing.
2. Set surface casing by circulating cement to the top.
3. File completion forms ACO-1 with K.C.C. within 90 days of well completion, following instructions on ACO-1, side 1, and including copies of wireline logs.
4. Notify District office 48 hours prior to old well workover or re-entry.
5. Prior to filing Intent, prepare a proposed plugging plan in case well is D & A, then obtain approval of plan when calling district office prior to setting surface pipe.
6. Submit plugging report (CP-4) to K.C.C. after plugging is completed.
7. Obtain an approved injection docket number before disposing of salt water.
8. Notify K.C.C. within 10 days when injection commences or terminates.
9. If an alternate 2 completion, cement in the production pipe from below any usable water to surface within 120 days of spud date.

**A Regular Section of Land  
1 Mile = 5,280 Ft.**

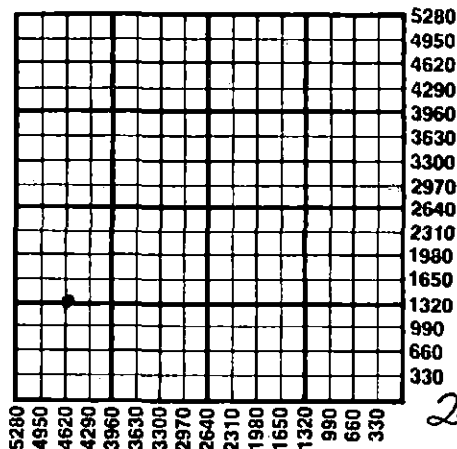

2-5-86

RECEIVED

STATE CORPORATION COMMISSION

FEB 5 1986

CONSERVATION DIVISION

State Corporation Commission of Kansas  
Conservation Division  
200 Colorado Derby Building  
Wichita, Kansas 67202  
(316) 263-3238