


DP

WELL PLUGGING RECORD

15-079-30069-0000

Give All Information Completely
Make Required Affidavit
Mail or Deliver Report to:
Conservation Division
State Corporation Commission
212 No. Market
Wichita, Kansas

NORTH

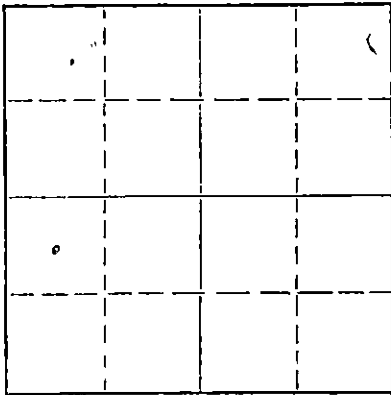

Locate well correctly on above Section Plat

Harvey County, Sec. 7 Twp. 22S Rge. (E) 2 (W)
Location as "NE/CNW/SW" or footage from lines C NW SW
Lease Owner Donald C. Slawson
Lease Name Krehbiel A Well No. 1
Office Address Suite 408 One Twenty Bldg., Wichita, Kansas
Character of Well (completed as Oil, Gas or Dry Hole) oil
Date well completed Feb. 14 19 65
Application for plugging filed May 4 19 67
Application for plugging approved 19
Plugging commenced May 19 19 67
Plugging completed May 22 19 67
Reason for abandonment of well or producing formation depleted

If a producing well is abandoned, date of last production 19
Was permission obtained from the Conservation Division or its agents before plugging was commenced? yes

Name of Conservation Agent who supervised plugging of this well Hugh E. Scott
Producing formation _____ Depth to top _____ Bottom _____ Total Depth of Well 3295 Feet
Show depth and thickness of all water, oil and gas formations.

OIL, GAS OR WATER RECORDS

CASING RECORD

FORMATION	CONTENT	FROM	TO	SIZE	PUT IN	PULLED OUT
		0	204'	8 5/8"	204'	none
		0	3294'	4 1/2"	3294'	2796.35

Describe in detail the manner in which the well was plugged, indicating where the mud fluid was placed and the method or methods used in introducing it into the hole. If cement or other plugs were used, state the character of same and depth placed, from _____ feet to _____ feet for each plug set.

Pushed plug to 3050', set 10' rock bridge and dumped 4 sacks of cement at 3040'.
Set 10' rock bridge at 220' and dumped 25 sacks of cement. Filled hole with mud to 40', set 10' rock bridge and capped hole with 10 sacks of cement.

RECEIVED
STATE CORPORATION COMMISSION
JUN 6 1967

CONSERVATION DIVISION
Wichita, Kansas

(If additional description is necessary, use BACK of this sheet)
Name of Plugging Contractor Pipe Pullers, Inc. 6-6-67
Address Box 486, Ellinwood, Kansas

STATE OF Kansas, COUNTY OF Barton, ss.
Dean Wells (employee of owner) or (owner or operator) of the above-described well, being first duly sworn on oath, says: That I have knowledge of the facts, statements, and matters herein contained and the log of the above-described well as filed and that the same are true and correct. So help me God.

(Signature) Dean Wells
Ellinwood, Kansas (Address)

SUBSCRIBED AND SWORN TO before me this 31 day of May, 19 67

My commission expires July 7, 1968 Notary Public.

WELL LOG

Company: Donald C. Slawson
408 One Twenty Building
Wichita, Kansas 67202

Farm: Krehbiel 'A' #1
C NW SW of Section 7-22S-2W
Harvey County, Kansas

Total Depth: 3295' Elevation: 1451 D.F.

Commenced: February 4, 1965
Completed: February 14, 1965

Contractor: Slawson Drilling Company, Inc.

Casing: 8 5/8" @ 204' with 200 sx cement
4 1/2" @ 3294' with 100 sx cement


0-35	Surface Clay
35-80	Sand
80-1200	Lime & Shale
1200-1720	Shale & Lime
1720-2014	Lime & Shale
2014-2192	Lime
2192-2306	Sand
2306-2422	Shale & Lime
2422-2512	Lime
2512-2642	K. C. Lime
2642-2931	Lime
2931-3138	Lime & Shale
3138-3139	Cong.
3139-3295	Miss.
3295	Total Depth

STATE OF KANSAS)
COUNTY OF SEDGWICK) ss:

I, Donald C. Slawson, of the Slawson Drilling Company, Inc., upon oath state that the above and foregoing is a true and correct copy of the log of the Krehbiel 'A' #1 well.


DONALD C. SLAWSON

Subscribed and sworn to before me this 23rd day of February, 1965.

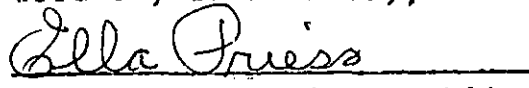
Ella Priess, Notary Public

My Commission Expires:
August 25, 1968

RECEIVED
GAME CORPORATION COMMISSION

MAY 5 1967

CONSERVATION DIVISION
Wichita, Kansas