


Give All Information Completely  
Make Required Affidavit  
Mail or Deliver Report to:  
Conservation Division  
State Corporation Commission  
212 No. Market  
Wichita, Kansas

WELL PLUGGING RECORD

Hodgeman County, Sec. 17 Twp. 22 Rge. (E) 22 (W)  
Location as "NE/CNW/SW" or footage from lines SW SW  
Lease Owner Sun Oil Company  
Lease Name Dan Ewy Well No. 5  
Office Address 800 Security Life Bldg.  
Character of Well (completed as Oil, Gas or Dry Hole) Oil  
Date well completed 6-3 19 63  
Application for plugging filed 12-12 19 73  
Application for plugging approved 12-14 19 73  
Plugging commenced 9-5- 19 74  
Plugging completed 9-18 19 74  
Reason for abandonment of well or producing formation Depleted

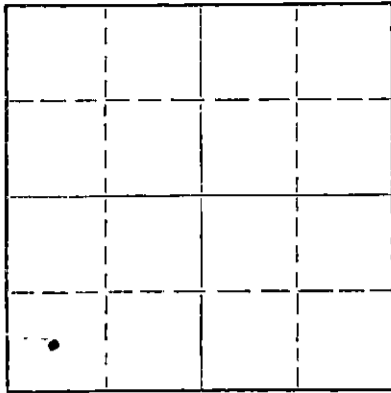

Locate well correctly on above  
Section Plat

If a producing well is abandoned, date of last production 19  
Was permission obtained from the Conservation Division or its agents before plugging was commenced? Yes

Name of Conservation Agent who supervised plugging of this well Edgar Eves  
Producing formation Mississippi Depth to top 4493 Bottom 4508 Total Depth of Well 4508 Feet  
Show depth and thickness of all water, oil and gas formations.

OIL, GAS OR WATER RECORDS

CASING RECORD

FORMATION	CONTENT	FROM	TO	SIZE	PUT IN	PULLED OUT
				8 5/8	746	-
				5 1/2	4493	2924

Describe in detail the manner in which the well was plugged, indicating where the mud fluid was placed and the method or methods used in introducing it into the hole. If cement or other plugs were used, state the character of same and depth placed, from feet to feet for each plug set.

Plugged with sand to 4480 ft. Dumped 4 sx cement with dump bailer.  
Shot at 2924' Pulled and layed down 2924 ft. of 5 1/2" casing.  
Plugged with 80 sx cement, 14 sx gel, 30 sx cement, 8 sx gel, and 10 sx cement.

RECEIVED  
STATE CORPORATION COMMISSION  
SEP 30 1974  
CONSERVATION DIVISION  
Wichita, Kansas

(If additional description is necessary, use BACK of this sheet)  
Name of Plugging Contractor Charlie Crow Drilling Co.  
Address Box 706, Hays, Kansas

STATE OF COLORADO, COUNTY OF DENVER, ss.  
D. A. Coppedge (employee of owner) or (owner or operator) of the above-described well, being first duly sworn on oath, says: That I have knowledge of the facts, statements, and matters herein contained and the log of the above-described well as filed and that the same are true and correct. So help me God.

(Signature) *D. A. Coppedge*  
800 Security Life Bldg., Denver, Co. 80202  
(Address)

SUBSCRIBED AND SWORN TO before me this 25th day of September, 1974

My commission expires Nov. 22, 1975

*Mary Marson*  
Notary Public.

Sunray DX Oil Company  
Tulsa, Oklahoma

Tulsa, Oklahoma  
June 7, 1963

Contractor: Stickle Drilling Company  
Date Commenced: May 26, 1963  
Date Completed: June 3, 1963

D. J. Ewy No. 5  
SW SW Sec. 17-22S-22W  
Hodgeman County, Kans.


DRILLER'S LOG

Depth Figures Indicate Base of Formation:

Shale and shells	247
Red bed and shale	460
Sand, shale and red bed	1560
Shale	2213
Shale and lime	2475
Lime and shale	2634
Lime	2940
Shale	3378
Shale and lime	3483
Shale and chalk	3750
Shale and lime	3920
Lime	4508 TD

RECEIVED  
STATE CORPORATION COMMISSION  
DEC 14 1973  
CONSERVATION DIVISION  
Wichita, Kansas

I, Fred E. Stickle, hereby certify the above to be a true and complete Driller's Log of Sunray DX Oil Company's D. J. Ewy No. 5 Well, SW SW Section 17-22S-22W, Hodgeman County, Kansas.

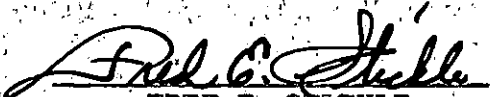  
FRED E. STICKLE

  
Notary Public

My Commission Expires January 11, 1967