


WELL PLUGGING RECORD

Give All Information Completely
Make Required Affidavit
Mail or Deliver Report to:
Conservation Division
State Corporation Commission
211 No. Broadway
Wichita, Kansas

Hodgeman County, Sec. 17 Twp. 22S Rge. 22W (E) (W)
Location as "NE/CNW/SW" or footage from lines C SE NW
Lease Owner Sunray DX Oil Company
Lease Name Dan Ewy Well No. 4
Office Address 321 West Douglas, Wichita 2, Kansas
Character of Well (completed as Oil, Gas or Dry Hole) Dry Hole
Date well completed 19 63
Application for plugging filed May 29 19 63
Application for plugging approved June 3 19 63
Plugging commenced June 20 19 63
Plugging completed June 24 19 63
Reason for abandonment of well or producing formation Non-Commercial

NORTH

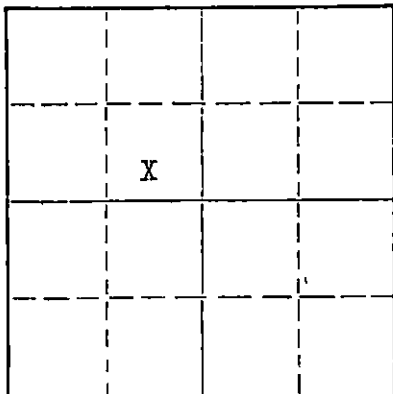

Locate well correctly on above
Section Plat

If a producing well is abandoned, date of last production 19
Was permission obtained from the Conservation Division or its agents before plugging was commenced? Yes

Name of Conservation Agent who supervised plugging of this well Mr. Hugh Scott, Sublette, Kansas
Producing formation _____ Depth to top _____ Bottom _____ Total Depth of Well 4537 Feet
Show depth and thickness of all water, oil and gas formations.

OIL, GAS OR WATER RECORDS

CASING RECORD

FORMATION	CONTENT	FROM	TO	SIZE	PUT IN	PULLED OUT
Lsg. Kansas City	Water	3900	4315	8-5/8	249'	0'
Marmaton	Water	4315	4510	5-1/2	4533'	3615'
Mississippi	Water	4510	4537			

Describe in detail the manner in which the well was plugged, indicating where the mud fluid was placed and the method or methods used in introducing it into the hole. If cement or other plugs were used, state the character of same and depth placed, from _____ feet to _____ feet for each plug set.
Filled hole with sand from total depth to 4120' and placed 5 sacks of cement to 4080'.
Shot 5 1/2" casing at 3615' and pulled. Filled hole with mud from 4080' to 240' and placed 10' rock bridge to 230' and 20 sacks of cement to 170'. Filled with mud to 40' and placed 10' rock bridge to 30' and 10 sacks of cement to surface. Well plugged and abandoned.

RECEIVED
STATE CORPORATION COMMISSION

JUN 26 1963

CONSERVATION DIVISION
Wichita, Kansas

(If additional description is necessary, use BACK of this sheet)

Name of Plugging Contractor Forbes Casing Pulling Company, Inc.
Address Box 221, Great Bend, Kansas

STATE OF KANSAS, COUNTY OF SEDGWICK, ss.
GARY W. PIERCE (employee of owner) or ~~(owner or operator)~~ of the above-described well, being first duly sworn on oath, says: That I have knowledge of the facts, statements, and matters herein contained and the log of the above-described well as filed and that the same are true and correct. So help me God.

(Signature) Gary W. Pierce
321 West Douglas, Wichita 2, Kansas
(Address)

SUBSCRIBED AND SWORN TO before me this 25th day of June, 1963

Wm Montgomery
Notary Public.

My commission expires July 13, 1963

Sunray DX Oil Company
Tulsa, Oklahoma

Tulsa, Oklahoma
March 13, 1963

Contractor: Stickle Drilling Company
Date Commenced: March 2, 1963
Date Completed: March 11, 1963

Dan Ewy "A" No. 4
SE NW Section 17-22S-22W
Hodgeman County, Kansas

DRILLER'S LOG

Depth Figures Indicate Base of Formation:


Clay and sand	100
Shale	250
Red bed and clay	900
Sand	1130
Red bed and shale	1460
Shale and shells	1825
Shale and lime	2325
Lime and shale	2465
Lime	2705
Lime and shale	2945
Lime	3088
Shale and chalk	3260
Shale and lime	3548
Shale and chalk	3780
Shale and lime	3918
Lime	4000
Lime and shale	4195
Lime	4290
Lime and shale	4324
Lime	4490
Lime and cherty lime	4539 TD
Corrected TD	4537

RECEIVED
STATE CORPORATION COMMISSION

JUN 3 1963

CONSERVATION DIVISION
Wichita, Kansas

I, Fred E. Stickle, hereby certify the above to be a true and complete Driller's Log of Sunray DX Oil Company's Dan Ewy "A" No. 4, SE NW Section 17-22S-22W in Hodgeman County, Kansas.

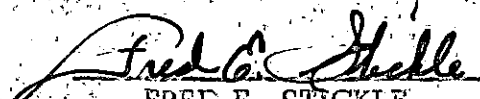
FRED E. STICKLE


Notary Public

My Commission Expires January 11, 1967