

STATE OF KANSAS
STATE CORPORATION COMMISSION

Form CP-4


Give All Information Completely
Make Required Affidavit
Mail or Deliver Report to:
Conservation Division
State Corporation Commission
212 No. Market
Wichita, Kansas

WELL PLUGGING RECORD

Hodgeman County, Sec. 17 Twp. 22 Rge. (E) 22 (W)

Location as "NE/CNW/SW" or footage from lines NW SW
Lease Owner Sun Oil Company
Lease Name Dan Ewy Well No. 1
Office Address 800 Security Life Bldg.
Character of Well (completed as Oil, Gas or Dry Hole) Oil
Date well completed 7-28 19 62
Application for plugging filed 12-12 19 73
Application for plugging approved 12-14 19 73
Plugging commenced 9-12 19 74
Plugging completed 9-18 19 74
Reason for abandonment of well or producing formation Depleted

NORTH

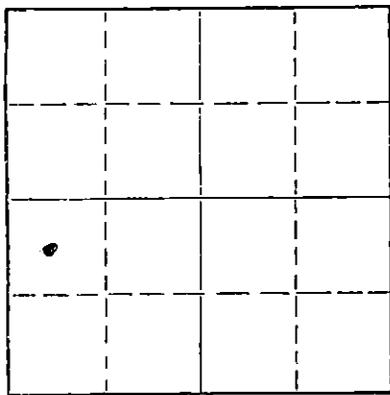

Locate well correctly on above Section Plat

If a producing well is abandoned, date of last production 19
Was permission obtained from the Conservation Division or its agents before plugging was commenced? Yes

Name of Conservation Agent who supervised plugging of this well Edgar Eves
Producing formation Marm Depth to top 4245 Bottom 4256 Total Depth of Well 4563 Feet
Show depth and thickness of all water, oil and gas formations.

OIL, GAS OR WATER RECORDS

CASING RECORD

FORMATION	CONTENT	FROM	TO	SIZE	PUT IN	PULLED OUT
				8 5/8	255	-
				5 1/2	4553	2920

Describe in detail the manner in which the well was plugged, indicating where the mud fluid was placed and the method or methods used in introducing it into the hole. If cement or other plugs were used, state the character of same and depth placed, from feet to feet for each plug set.

Set plug at 4230 and dumped 4 sx cement with dump bailer.
Shot casing at 2920. Pulled and layed down 2920 feet 5 1/2" casing.
Plugged with 80 sx cement. 14 sx gel. 30 sx cement, 8 sx gel, and 10 sx. cement.
Plug at surface

RECEIVED
STATE CORPORATION COMMISSION
SEP 30 1974
CONSERVATION DIVISION
Wichita, Kansas

(If additional description is necessary, use BACK of this sheet)

Name of Plugging Contractor Charlie Crow Drilling Co.
Address Box 706. Hays. Kansas

STATE OF COLORADO, COUNTY OF DENVER, ss.
D. A. Coppedge (employee of owner) or (owner or operator) of the above-described well, being first duly sworn on oath, says: That I have knowledge of the facts, statements, and matters herein contained and the log of the above-described well as filed and that the same are true and correct. So help me God.

(Signature) [Signature]
800 Security Life Bldg., Denver, Co. 80202
(Address)

SUBSCRIBED AND SWORN TO before me this 25th day of September, 1974

[Signature]
Notary Public.

My commission expires Nov. 22, 1975

WELL LOG

COMPANY SUNRAY D-X OIL COMPANY

SEC. 17 T. 22S R. 22W

FARM EWY NO. 1


LOC. C-NW, SW

TOTAL DEPTH 4563'

COUNTY HODGEMAN CO., KANSAS

COMM. July 17, 1962 COMP. July 28, 1962

CONTRACTOR GARVEY DRILLING COMPANY

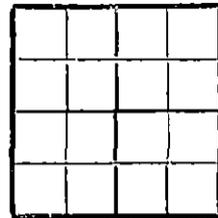

CASING 8-5/8" @ 255' w/200 sax.
5 1/2" @ 4553' w/100 sax.

ELEVATION 2245' DF

PRODUCTION

FIGURES INDICATE BOTTOM OF FORMATIONS

RECEIVED
STATE CORPORATION COMMISSION
DEC 14 1973
CONSERVATION DIVISION
Wichita, Kansas

100	Surface clay & sand
255	Shale
758	Shale w/sand streaks
768	Blaine anhydrite
870	Shale
970	Sand
1065	Shale & sand
1371	Shale
1444	Anhydrite
1455	Shale
2065	Shale & shells
2420	Shale & lime
2685	Lime
2795	Shale & lime
2955	Shale & shells
3590	Shale & lime
3650	Lime & shale
3890	Shale & lime
4217	Lime
4310	Shale & lime
4359	Lime & shale
4409	Lime
4518	Shale & lime
4563	Lime
4563	T. D.

State of KANSAS
County of BARTON } ss

I, VERNE A. MORRIS of GARVEY DRILLING COMPANY
upon oath state the above and foregoing is a true and correct copy of the log of the #1 EWY well.

Subscribed and sworn to before me this 17th day of August 19 62

My Commission Expires: November 12, 1962

NOTARY PUBLIC