


WELL PLUGGING RECORD

Give All Information Completely
Make Required Affidavit
Mail or Deliver Report to:
Conservation Division
State Corporation Commission
211 No. Broadway
Wichita, Kansas

Hodgeman County, Sec. 17 Twp. 22S Rge. SE SE (X) 22 (W)

NORTH

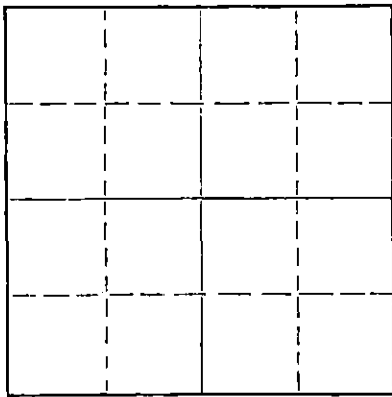

Locate well correctly on above
Section Plat

Location as "NE/CNW/SW" or footage from lines _____
Lease Owner Rains & Williamson Oil Co.
Lease Name EWY "A" Well No. 3
Office Address 412 Union Center - Wichita, Kansas
Character of Well (completed as Oil, Gas or Dry Hole) Dry Hole
Date well completed 7-19 19 63
Application for plugging filed 7-19 19 63
Application for plugging approved 7-19 19 63
Plugging commenced 7-19 19 63
Plugging completed 7-19 19 63
Reason for abandonment of well or producing formation No oil or gas found
in commercial quantities
If a producing well is abandoned, date of last production ----- 19 --
Was permission obtained from the Conservation Division or its agents before plugging was com-
menced? Yes

Name of Conservation Agent who supervised plugging of this well Mr. Hugh Scott, Sublette, Kansas
Producing formation ----- Depth to top --- Bottom --- Total Depth of Well 4519 Feet
Show depth and thickness of all water, oil and gas formations.

OIL, GAS OR WATER RECORDS

CASING RECORD

FORMATION	CONTENT	FROM	TO	SIZE	PUT IN	PULLED OUT
				8-5/8"	250'	NONE

Describe in detail the manner in which the well was plugged, indicating where the mud fluid was placed and the method or methods used in introducing it into the hole. If cement or other plugs were used, state the character of same and depth placed, from _____ feet to _____ feet for each plug set.

Filled hole with rotary mud to 700'. Set plug at 700', and cemented through drill pipe with Globe with 20 sacks cement. Filled hole with rotary mud to 200'. Set second plug and cemented through drill pipe with 20 sacks of cement. Filled hole with rotary mud to 40' of base of cellar, set third plug and cemented through drill pipe with 15 sacks of cement. Job completed at 2:30 A.M., July 19, 1963.

RECEIVED
STATE CORPORATION COMMISSION

JUL 23 1963

CONSERVATION DIVISION
Wichita, Kansas

(If additional description is necessary, use BACK of this sheet)

Name of Plugging Contractor Rains & Williamson Oil Co.
Address 412 Union Center - Wichita, Kansas

STATE OF KANSAS, COUNTY OF SEDGWICK, ss.

Wilson Rains - Partner (~~XXXXXXXXXX~~) or (owner or operator) of the above-described well, being first duly sworn on oath, says: That I have knowledge of the facts, statements, and matters herein contained and the log of the above-described well as filed and that the same are true and correct. So help me God.

(Signature) Wilson Rains Wilson Rains
412 Union Center - Wichita, Kansas
(Address)

SUBSCRIBED AND SWORN TO before me this 22nd day of July, 19 63

My commission expires November 8, 1966

Sherry Gish
Sherry Gish Notary Public.



ROTARY DRILLING LOG

OPERATOR: Rains & Williamson Oil Co.
 NO. 3 EWY "A"
 SE SE Section 17-22S-22W
 Hodgeman County, Kansas

CONTRACTOR: Rains & Williamson
 Oil Co.
 COMMENCED: 7-6-63
 COMPLETED: 7-19-63

Remarks: Set 8-5/8" surface casing at 250', cemented with 150 sacks Globe Quick Cement.

Formations


Shale	765'
Anhydrite	780'
Shale and Shells	850'
Sand	1040'
Red Bed	1160'
Shale and Red Bed	1395'
Anhydrite	1430'
Shale and Shells	2185'
Shale and Lime	2250'
Lime and Shale	2680'
Shale and Lime	3840'
Lime and Shale	3925'
Lime	3975'
Lime and Shale	4265'
Lime	4300'
Lime and Shale	4478'
Lime	4493'
Lime and Chert	4519'
Rotary Total Depth (D&A)	4519'

We certify the above log is true and correct to the best of our knowledge and belief.

RAINS & WILLIAMSON OIL CO.


 Wilson Rains
 Partner

Subscribed and sworn to before me, a Notary Public within and for the State of Kansas, County of Sedgwick, this 22nd day of July, 1963.

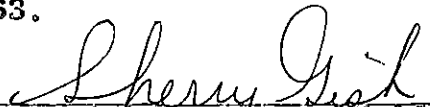
 Sherry Gish Notary Public

My Commission Expires:
 --- November 8, 1966

RECEIVED
 STATE CORPORATION COMMISSION

JUL 23 1963

CONSERVATION DIVISION
 Wichita, Kansas