


Give All Information Completely  
Make Required Affidavit  
Mail or Delivery Report to:  
Conservation Division  
State Corporation Commission  
800 Bitting Building  
Wichita, Kansas

WELL PLUGGING RECORD  
OR  
FORMATION PLUGGING RECORD

Strike out upper line  
when reporting plug-  
ging off formations.

NORTH

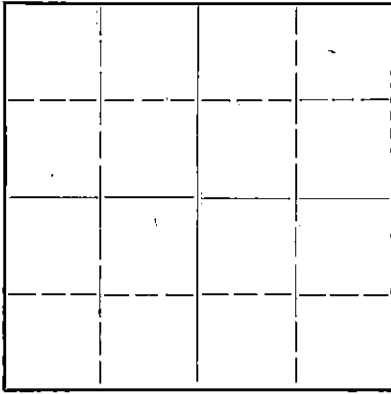

Locate well correctly on above  
Section Plat

Stafford County, Sec. 23 Twp. 23 Rge. 12 (E) 12 (W)

Location as "NE $\frac{1}{4}$ NW $\frac{1}{4}$ SW $\frac{1}{4}$ " or footage from lines NW/4  
Lease Owner Phillips Petroleum Company  
Lease Name Thole Well No. 1  
Office Address Bartlesville, Oklahoma  
Character of Well (completed as Oil, Gas or Dry Hole) Dry Hole  
Date well completed 3-10-44 19  
Application for plugging filed 3-11-44 19  
Application for plugging approved 3-10-44 19  
Plugging commenced 3-10-44 19  
Plugging completed 3-10-44 19  
Reason for abandonment of well or producing formation Dry Hole  
If a producing well is abandoned, date of last production Dry Hole 19  
Was permission obtained from the Conservation Division or its agents before plugging was com-  
menced? Yes

Name of Conservation Agent who supervised plugging of this well C.T. Alexander  
Producing formation Depth to top Bottom Total Depth of Well 3846 $\frac{1}{2}$  Feet  
Show depth and thickness of all water, oil and gas formations.


OIL, GAS OR WATER RECORDS

CASING RECORD

Formation	Content	From	To	Size	Put In	Pulled Out
Lansing Kansas City	Dry	3374		8 5/8"	386'	None
Arbuckle	Dry	3818	3846 $\frac{1}{2}$			

Describe in detail the manner in which the well was plugged, indicating where the mud fluid was placed and the method or methods used in introducing it into the hold. If cement or other plugs were used, state the character of same and depth placed, from feet to feet for each plug set.

Filled w/ mud from 3846 $\frac{1}{2}$ ' to 393'. Ran 15 sax of cement @ 393'. Filled w/ mud to 26' & ran 15 sax of cement in filling from 26' to base of cellar. Mud & cement settles 47'. Ran 6 more sax cement in filling to base of cellar.

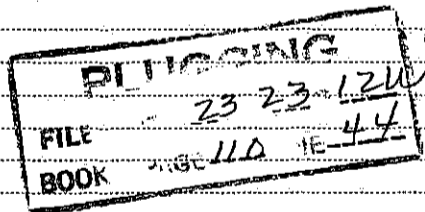

(If additional description is necessary, use BACK of this sheet)

Correspondence regarding this well should be addressed to F. W. Shelton  
Address Box 779 - Great Bend, Kansas

STATE OF Kansas, COUNTY OF Barton, ss.  
F. W. Shelton (employee of owner) or (owner or operator) of the above-described well,  
being first duly sworn on oath, says: That I have knowledge of the facts, statements, and matters herein contained and the log of the above-described well as filed and that the same are true and correct. So help me God.

(Signature) F. W. Shelton

(Address)

SUBSCRIBED AND SWORN TO before me this 27th day of March, 19 44

My commission expires

3-27-46

J. L. Marsh  
Notary Public.



*Start*

# Formation Record

Lease **Thole**

Well No. **1**

FROM	TO	Formation	REMARKS
0	11	Cellar	<u>Elevation 1246' D.F.</u>
11	149	Sand	
149	398	Red Bed	
398	408	Anhydrite	
408	660	Red Bed	
660	647	Anhydrite	
647	1196	Shale & Shells	
1196	1220	Salt & Shale	
1220	1545	Lime & Shale	
1545	1608	Lime	
1608	1690	Lime & Shale	
1690	1875	Lime	
1875	1890	Lime & Shale	
1890	1960	Lime	
1960	2175	Lime & Shale	
2175	2295	Shale & Shells	
2295	2370	Lime & Shale	
2370	2450	Lime	
2450	2650	Shale & Shells	
2650	2615	Lime & Shale	
2615	2632	Shale & Shells	
2632	2675	Lime	
2675	2925	Lime & Shale	
2925	3245	Lime	
3245	3289	Shale & Shells	
3289	3390	Lime & Shale	Top 100 3374'
3390	3657	Lime	
3657	3705	Conglomerate	
3705	3732	Lime	
3732	3796	Lime & Shale	
3796	3819	Shale & Sand	
3819	3846 1/2	Lime	Top Arbuckle 3819' - Streaked porosity w/ no shows.

15-185-0138-000

Top 100 3374'

Top Arbuckle 3819' - Streaked porosity w/ no shows.

**PLUGGING**  
 FILE # 23 23-124  
 BOOK PAGE 110 NE 44

