


WELL PLUGGING RECORD

Give All Information Completely  
Make Required Affidavit  
Mail or Deliver Report to:  
Conservation Division  
State Corporation Commission  
211 No. Broadway  
Wichita, Kansas

NORTH

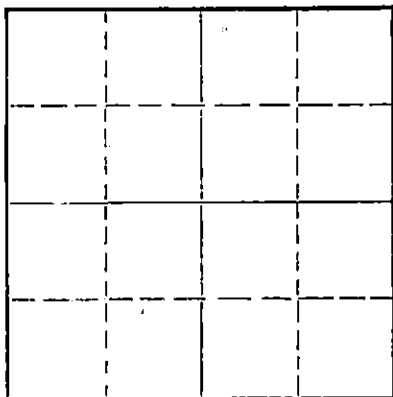

Locate well correctly on above  
Section Plat

Hodgman County. Sec. 9 Twp. 22S Rge. (E) 23 (W)  
Location as "NE/CNW/SW" or footage from lines G/NE/SW  
Lease Owner Pickrell Drilling Company  
Lease Name Campbell "G" Well No. 1  
Office Address Great Bend, Kansas  
Character of Well (completed as Oil, Gas or Dry Hole) \_\_\_\_\_  
Date well completed \_\_\_\_\_ 19\_\_\_\_  
Application for plugging filed \_\_\_\_\_ 19\_\_\_\_  
Application for plugging approved \_\_\_\_\_ 19\_\_\_\_  
Plugging commenced 12-18 19 61  
Plugging completed 12-24 19 61  
Reason for abandonment of well or producing formation \_\_\_\_\_

If a producing well is abandoned, date of last production \_\_\_\_\_ 19\_\_\_\_  
Was permission obtained from the Conservation Division or its agents before plugging was commenced? Yes

Name of Conservation Agent who supervised plugging of this well W. L. Lackamp, Jr.  
Producing formation \_\_\_\_\_ Depth to top \_\_\_\_\_ Bottom \_\_\_\_\_ Total Depth of Well 4690 Feet  
Show depth and thickness of all water, oil and gas formations.

OIL, GAS OR WATER RECORDS

CASING RECORD

FORMATION	CONTENT	FROM	TO	SIZE	PUT IN	PULLED OUT
				8 5/8"	278'	None
				5 1/2"	4688'	3810'

Describe in detail the manner in which the well was plugged, indicating where the mud fluid was placed and the method or methods used in introducing it into the hole. If cement or other plugs were used, state the character of same and depth placed, from \_\_\_\_\_ feet to \_\_\_\_\_ feet for each plug set.

Plug @ 4670'  
Top Perforation @ 4234'

Sanded hole to 3400' - dumped 5 sks  
cement - pulled casing - bailed fluid down to  
350' - set 10' rock bridge - dumped 20 sks  
cement - mudded hole to 35' - set 10' rock  
bridge - dumped 10 sks cement to base of cellar

*2nd 1-10-62*

JAN 3 1962

(If additional description is necessary, use BACK of this sheet)

Name of Plugging Contractor R & D Casing Pulling Company License # 236  
Address Box # 572, Hutchinson, Kansas

STATE OF KANSAS, COUNTY OF SEDGWICK, ss.  
C. W. Sebitts (employee of owner) or (owner or operator) of the above-described well, being first duly sworn on oath, says: That I have knowledge of the facts, statements, and matters herein contained and the log of the above-described well as filed and that the same are true and correct. So help me God.

(Signature) C. W. Sebitts  
705 Fourth National Bank Bldg.  
(Address)

SUBSCRIBED AND SWORN TO before me this 2nd day of January 19 62

My commission expires September 24, 1962

Maxine Johnson  
Maxine Johnson Notary Public.



ROTARY DRILLING LOG

COMPANY: **Pickrell Drilling Company** Rotary Drilling Commenced 7-27-60  
 705 Fourth National Bank Bldg., Wichita, Kansas

LOCATION: **Campbell C-1 - C NE SW 9-228-23W** Rotary Drilling Completed 8-10-60  
**Hodgeman Co., Kansas**

CONTRACTOR: **PICKRELL DRILLING COMPANY**  
 Wichita, Kansas

CASING RECORD: **Set 278' of 8 5/8" spiralweld casing, cemented with 170 sks.**  
**Cement circulated.**

**Ran 148 jts. 15 1/2" 8 thd. 5 1/2" cag. Set @ 4688', 90 sks cement.**

LOG

(Figures indicate bottom of formation — measurements from top of rotary casing.)

40	clay	<u>Circ. for Samples</u>
225	shale	
240	sand	4600
280	blue shale	4625
425	gray shale	4635
500	sand	4651
590	sandy gray shale	4656
1000	shale & red bed	4690
1015	blaine	
1085	red bed & shale	<u>Slope Tests</u>
1300	sand & shale	
1330	shale & strks sand	1000 - 0°
1615	shale & shells	2000 - 0°
1635	anhydrite	3000 - 0°
1800	shale	4000 - 0°
2350	shale & shells	
2485	shale & lime	<u>S.L.M.</u>
2815	lime & shale	
2850	lime	2903 - OK
3350	lime & shale	4000 - OK
3752	lime, shale, sand	
4140	lime & shale	
4609	lime	
4690	Miss. T.D.	

RECEIVED  
 JAN 11 1962  
 1-10-62  
 CONSERVATION DIVISION  
 WICHITA, KANSAS

The undersigned, G. W. Sebitta, Attorney-in-Fact for PICKRELL DRILLING COMPANY, hereby certifies in behalf of said Company, that the above is a true and correct log of the formation encountered in drilling the above well as reflected by the Daily Drilling Reports.

PICKRELL DRILLING COMPANY  
 By G. W. Sebitta  
 Attorney-in-Fact

STATE OF KANSAS }  
 COUNTY OF SEDGWICK } ss.:

On the 17th day of August, 1960, before me the undersigned, a Notary Public, in and for the County and State aforesaid, personally appeared G. W. Sebitta, to me known to be the legal person who subscribed the name of PICKRELL DRILLING COMPANY to the foregoing instrument as its Attorney-in-Fact and acknowledged to me that he executed the same as his free and voluntary act and deed, and as the free and voluntary act and deed of such company, for the uses and purposes therein set forth.

Witness my hand and seal of office the day and year last above written.

My commission expires: September 24, 1962

Maxine Johnson  
 Notary Public  
 Maxine Johnson