


STATE OF KANSAS  
STATE CORPORATION COMMISSION

WELL PLUGGING RECORD

Give All Information Completely  
Make Required Affidavit  
Mail or Deliver Report to  
Conservation Division  
State Corporation Comm.  
245 North Water  
Wichita, KS 67202

Hodgeman County. Sec. 9 Twp. 22S Rge. 23 E/W  
Location as "NE/CNW $\frac{1}{4}$ /SW $\frac{1}{4}$ " or footage from lines  
150' South of SE/4 NW/4  
Lease Owner Pate-Dombaugh, Inc.  
Lease Name Spreier Well No. 1  
Office Address 502 Union Center, Wichita, KS 67202  
Character of Well (Completed as Oil, Gas or Dry Hole)  
dry hole

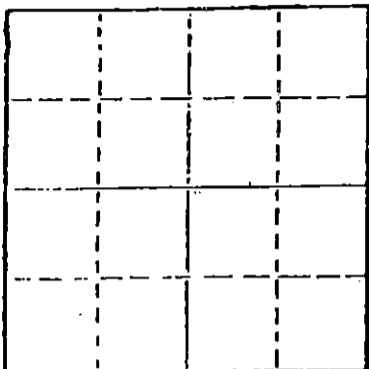

Locate well correctly on above  
Section Plot

Date Well completed 2/2 1983  
Application for plugging filed 2/2 1983  
Application for plugging approved 2/2 1983  
Plugging commenced 2/2 1983  
Plugging completed 2/2 1983

Reason for abandonment of well or producing formation  
No commercial quantity of oil or gas encountered.  
If a producing well is abandoned, date of last production  
19

Was permission obtained from the Conservation Division or  
its agents before plugging was commenced? yes

Name of Conservation Agent who supervised plugging of this well Mr. Leslie  
Producing formation Depth to top Bottom Total Depth of Well  
Show depth and thickness of all water, oil and gas formations.

OIL, GAS OR WATER RECORDS

CASING RECORD

FORMATION	CONTENT	FROM	TO	SIZE	PUT IN	PULLED OUT

Describe in detail the manner in which the well was plugged, indicating where the mud fluid was placed and the method or methods used in introducing it into the hold. If cement or other plugs were used, state the character of same and depth placed, from feet to feet for each plug set.

Total Depth 4635 feet. Set first plug at 1650 feet with 70 sacks of 50/50 poz mix cement, 4% Gel and 3% Calcium Chloride; set second plug at 450 feet with 40 sacks; 10 sacks and a bridge set at 40 feet and 10 sacks in the rathole. Job completed at 6:00 p.m. on February 2, 1983.

(If additional description is necessary, use BACK of this sheet)

Name of Plugging Contractor Kaw Drilling Co., Inc.

STATE OF KANSAS COUNTY OF SEDGWICK, ss. contractor  
K. S. Martin, President of Kaw Drilling Co., Inc. (employee of owner) or contractor or independent  
of the above-described well, being first duly sworn on oath, says: That I have knowledge of the facts, statements, and matters herein contained and the log of the above-described well as filed and that the same are true and correct. So help me God.


(Signature) K. S. Martin  
K. S. Martin, President 1010 Union Center  
(Address) Wichita, KS 67202

SUBSCRIBED AND SWORN TO before me this 4th day of February, 1983.

My commission expires December 10, 1983

Mary Susan Whaley Notary Public.

RECEIVED  
STATE CORPORATION COMMISSION

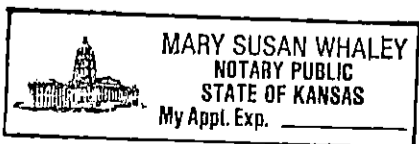

FEB 7 1983

CONSERVATION DIVISION  
Wichita, Kansas

OPERATOR: Pate-Dombaugh, Inc.  
 CONTRACTOR: Kaw Drilling Co., Inc.  
 WELL NAME: #1 SPREIER  
 LOCATION: 150' S of SE NW Sec. 9-22S-23W  
 Hodgeman County, Kansas  
 SPUD DATE: January 24, 1983  
 COMPLETION DATE: February 2, 1983

0	319	Shale
419	1515	Shale and Shell
2245	2502	Shale and Shell
2502	2715	Shell
2907	3077	Shale
3465	3648	Shale and Shell
3830	4002	Shale
4002	4170	Shale and Lime
4448	4528	Shale and Lime
	4635	R.T.D.

Spud hole at 6:30 p.m. on January 24, 1983. Drilled 419 feet of 12 1/4 inch hole. Ran 10 joints of new 8 5/8 inch casing. (Tallied at 404 feet.) Set at 416 feet with 235 sacks of 60/40 poz mix cement, 3% CC. Plug down at 4:00 a.m. on January 25, 1983.

Total Depth 4635 feet. Set first plug at 1650 feet with 70 sacks of 50/50 poz mix cement, 4% Gel and 3% Calcium Chloride; set second plug at 450 feet with 40 sacks; 10 sacks and a bridge at 40 feet and 10 sacks in the rathole. Job completed at 6:00 p.m. on February 2, 1983.

STATE OF KANSAS )  
 ) SS  
 COUNTY OF SEDGWICK )


I, K. S. Martin, President of Kaw Drilling Co., Inc., being first duly sworn and upon my oath, state that: I have knowledge of the facts, statements and matters herein contained and the log of the above described well as filed and that the same are true and correct. So help me God.

*K. S. Martin*  
 K. S. Martin, President

SUBSCRIBED AND SWORN to before me on this 4th day of February, 1983.

*Mary Susan Whaley*  
 Mary Susan Whaley, Notary Public

My Commission Expires:  
 December 10, 1983

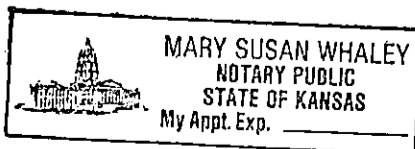

RECEIVED  
 STATE CORPORATION COMMISSION

FEB 7 1983

INSPECTION DIVISION  
 Wichita, Kansas